

STATE OF KANSAS
STATE CORPORATION COMMISSION

15.165.00175.0000


WELL PLUGGING RECORD

Give All Information Completely
Make Required Affidavit
Mail or Deliver Report to:
Conservation Division
State Corporation Commission
800 Bitting Building
Wichita, Kansas

RUSH

County. Sec. 24 Twp. 16S Rge. 16 (E) W (W)

NORTH

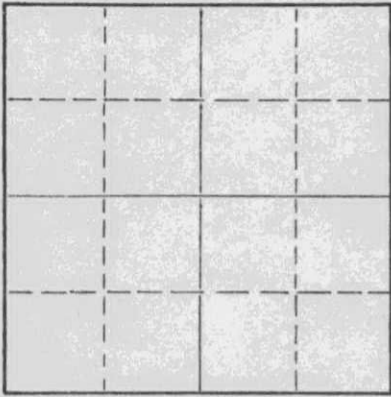

Locate well correctly on above
Section Plat

Location as "NE/CNW/SW" or footage from lines NE NE SE
Lease Owner Shelley-Miller Drilling, Inc.
Lease Name Maier Well No. 1
Office Address 205 Miller Building, Wichita, Kansas
Character of Well (completed as Oil, Gas or Dry Hole) Dry Hole
Date well completed November 30 19 55
Application for plugging filed November 30 19 55
Application for plugging approved November 30 19 55
Plugging commenced November 30 19 55
Plugging completed November 30 19 55
Reason for abandonment of well or producing formation Failure to produce
in commercial quantities

If a producing well is abandoned, date of last production 19
Was permission obtained from the Conservation Division or its agents before plugging was commenced? Yes

Name of Conservation Agent who supervised plugging of this well R. M. Brundege
Producing formation _____ Depth to top _____ Bottom _____ Total Depth of Well 3560 Feet
Show depth and thickness of all water, oil and gas formations.

OIL, GAS OR WATER RECORDS

CASING RECORD

FORMATION	CONTENT	FROM	TO	SIZE	PUT IN	PULLED OUT
				8 5/8	1022	

Describe in detail the manner in which the well was plugged, indicating where the mud fluid was placed and the method or methods used in introducing it into the hole. If cement or other plugs were used, state the character of same and depth placed, from _____ feet to _____ feet for each plug set.

Bottom Plug set @ 200' - 20 sacks cement
Top Plug set @ 35' - 10 sacks cement

RECEIVED
STATE CORPORATION COMMISSION
DEC 7 - 1955
CONSERVATION DIVISION
Wichita, Kansas

(If additional description is necessary, use BACK of this sheet)

Name of Plugging Contractor _____
Address _____

STATE OF KANSAS, COUNTY OF SEDGWICK, ss.
Richard A. Shelley (employee of owner) or (owner or operator) of the above-described well, being first duly sworn on oath, says: That I have knowledge of the facts, statements, and matters herein contained and the log of the above-described well as filed and that the same are true and correct. So help me God.

(Signature) Richard A. Shelley
205 Miller Building, Wichita, Kansas
(Address)

SUBSCRIBED AND SWORN TO before me this 5 day of December, 19 55

My commission expires March 24, 1956

Leona M. Baker
Notary Public.

PLUGGING
FILE SEC 24 T 16 R 16W
BOOK PAGE 21 LINE 8

15-165-00175-0000

COMPANY:

Shelley-Miller Drilling, Inc.
205 Miller Building
Wichita, Kansas

Rotary Drilling Commenced: 11-18-55
Rotary Drilling Completed: 11-30-55

LOCATION:

Maier No. 1
NE NE SE 24-16S-16W
Rush County, Kansas

CONTRACTOR:

Shelley-Miller Drilling, Inc
205 Miller Building
Wichita, Kansas

CASING RECORD:

8 5/8" 28# Slms Casing Set @ 1022'
Cemented with 400 sacks of cement

L O G

(Measurements from top of Rotary Bushing to bottom of formation)

Clay	10
Limestone & Shale	55
Shale & Shells	350
Clay & Shale	540
Sand	646
Red Bed	1,017
Anhydrite	1,052
Red Bed & Shale	1,500
Shale & Shells	1,850
Lime & Shale	2,100
Lime	2,230
Lime & Shale	2,965
Lime	3,490
Conglomerate	3,510
Lime	3560 Rotary Total Depth

The undersigned, Richard A. Shelley, President of Shelley-Miller Drilling, Inc., hereby certifies in behalf of said company, that the above log is a true and correct log of the formation encountered in drilling the above well as reflected by Daily Drilling Reports.

SHELLEY-MILLER DRILLING, INC.

By Richard A. Shelley
President

STATE OF KANSAS)
COUNTY OF SEDGWICK) SS

BE IT REMEMBERED, that on this 5th day of December, 1955, before me, the undersigned, a Notary Public, duly commissioned in and for the county and state aforesaid, came Richard A. Shelley, President, and known to me to be the same person who executed the foregoing instrument of writing in behalf of Shelley-Miller Drilling, Inc., as President of said company, and he duly acknowledged the execution of the same for himself and for said company.

IN WITNESS WHEREOF, I have hereunto set my hand and official seal on the day and year last above written.

Leona M. Baker
Notary Public

My Commission Expires:
March 24, 1956

PLUGGING
FILE SEC 24-16-R-16W
BOOK PAGE 24 LINE 8