


Give All Information Completely
Make Required Affidavit
Mail or Deliver Report to:
Conservation Division
State Corporation Commission
211 No. Broadway
Wichita, Kansas

WELL PLUGGING RECORD

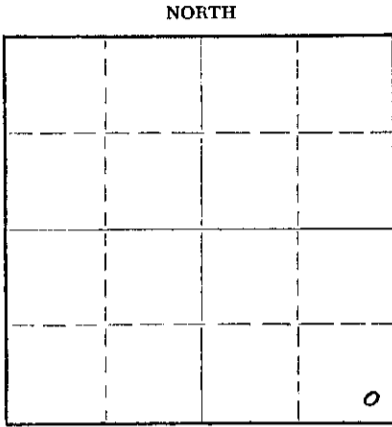

Locate well correctly on above Section Plat

Reno County, Sec. 5 Twp. 23 Rge. 8 (E) W (W)
Location as "NE/CNW/SW" or footage from lines SE SE SE
Lease Owner Harms-Burt Drilling Company
Lease Name Trueheart Well No. 1
Office Address Box 184, Great Bend, Kansas
Character of Well (completed as Oil, Gas or Dry Hole) Dry Hole
Date well completed October 26 19 56
Application for plugging filed " " 19 56
Application for plugging approved " " (Verbally) 19 56
Plugging commenced " " 19 56
Plugging completed " " 19 56
Reason for abandonment of well or producing formation Dry Hole

If a producing well is abandoned, date of last production _____ 19____
Was permission obtained from the Conservation Division or its agents before plugging was commenced? Yes

Name of Conservation Agent who supervised plugging of this well Ruel Durkee, Box 597, McPherson, Kansas
Producing formation _____ Depth to top _____ Bottom _____ Total Depth of Well 4106 Feet
Show depth and thickness of all water, oil and gas formations.

OIL, GAS OR WATER RECORDS

CASING RECORD

FORMATION	CONTENT	FROM	TO	SIZE	PUT IN	PULLED OUT
Surface		0	220'	8 5/8"	220'	None

Describe in detail the manner in which the well was plugged, indicating where the mud fluid was placed and the method or methods used in introducing it into the hole. If cement or other plugs were used, state the character of same and depth placed, from _____ feet to _____ feet for each plug set.

Filled hole with mud from total depth to 210' with plug set and 20 sacks of cement on plug. Filled with mud to 35' with plug and 10 sacks of cement on plug.

(If additional description is necessary, use BACK of this sheet)
Name of Plugging Contractor Harms-Burt Drilling Company
Address Box 184, Great Bend, Kansas

STATE OF Kansas, COUNTY OF Barton, ss.
H. Allan Harms (employee of owner) or (owner or operator) of the above-described well, being first duly sworn on oath, says: That I have knowledge of the facts, statements, and matters herein contained and the log of the above-described well as filed and that the same are true and correct. So help me God.

(Signature) [Signature]
Box 184, Great Bend, Kansas
(Address)

SUBSCRIBED AND SWORN TO before me this 12 day of November, 19 56
Mary E Van Pelt
Notary Public.

My commission expires January 20, 1958

PLUGGING
FILE SEC. 5 T. 23 R. 8W
BOOK PAGE 116 LINE 2

11-14-56
CONSERVATION DIVISION

DRILLERS LOG

Company: Harms-Burt Drilling Company

SE SE SE, Section 5-23S-8W

Farm: Trueheart #1

Reno County, Kansas

Commenced: October 10, 1956

Completed: October 28, 1956

Elevation: 1676 KB

0 - 30	soil & clay
30 - 135	sand
135 - 220	red bed
220 - 1080	shale & red bed
1080 - 1395	shale & shells
1395 - 1795	lime & shale
1795 - 1902	shale
1902 - 1975	shale & lime
1975 - 2175	shale
2175 - 2545	shale & Lime
2545 - 2765	lime & shale
2765 - 2979	lime
2979 - 3114	shale sand
3114 - 3143	lime & shale
3143 - 3580	lime
3580 - 3643	lime & shale
3643 - 3709	lime & chert
3709 - 3827	shale-lime
3827 - 3878	lime & shale
3878 - 3949	shale & lime
3949 - 3973	Viola Lime
3973 - 4056	sand & shale
4056 - 4106	lime
4106	Total Depth

Set 220' of 8 5/8" surface pipe. Cemented with 200 sacks of common cement & 3 sacks of calcium chloride.

Tops:	Heebner	2956'
	Br. Lime	3143'
	Lansing	3157'
	Mississippi	3643'
	Kinderhook	3714'
	Viola	3949'
	Simpson	3973'
	Arbuckle	4056'

Drill Stem Test: #1 3646-3663 Open 1 1/2 Hrs. Shut in 30 min. Rec. 115' oil Specked & gas cut mud. BHP-205#

Ran electric log.

Dry, plugged and abandoned.

PLUGGING	
FILE SEC	5 T 23 R 8W
BOOK PAGE	116 LINE 2

A F F I D A V I T

State of Kansas)
) SS
County of Barton)

NOTARIAL COMMISSION
NOV 14 1956

I, Allan Harms, of Harms-Burt Drilling Company, being first duly sworn on oath state: I have knowledge of the facts, statements, and matters herein contained and the same are true and correct.

Allan Harms

Subscribed and sworn to before me this 12-day of November 1956.

Comm. Expires 1-20-58

Mary E Van Pelt
Notary Public