


15-159-00333-00-00

STATE OF KANSAS
STATE CORPORATION COMMISSION

Give All Information Completely
Make Required Affidavit
Mail or Deliver Report to:
Conservation Division
State Corporation Commission
800 Bitting Building
Wichita, Kansas

WELL PLUGGING RECORD

Rice County. Sec. 19 Twp. 21 Rge. 6 (E) (W)
Location as "NE/CNW%SW%" or footage from lines NE NE NW
Lease Owner Gould & Bennett
Lease Name Johnson Well No. _____
Office Address 5830 N. Broadway
Character of Well (completed as Oil, Gas or Dry Hole) Dr Hole
Date well completed 7-3-54 19____
Application for plugging filed 7-3-54 19____
Application for plugging approved 7-3-54 19____
Plugging commenced 7-3-54 19____
Plugging completed 7-3-54 19____
Reason for abandonment of well or producing formation Dry Hole

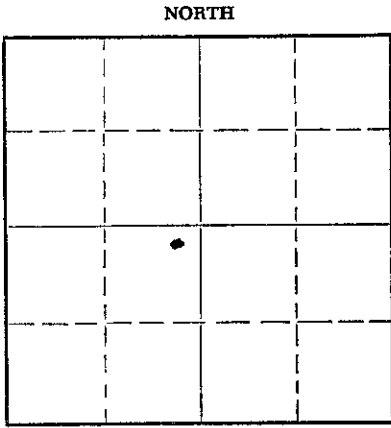

Locate well correctly on above
Section Flat

If a producing well is abandoned, date of last production _____ 19____
Was permission obtained from the Conservation Division or its agents before plugging was commenced? Yes

Name of Conservation Agent who supervised plugging of this well Ruhl Durkee
Producing formation _____ Depth to top _____ Bottom _____ Total Depth of Well 3530 Feet
Show depth and thickness of all water, oil and gas formations.

OIL, GAS OR WATER RECORDS

CASING RECORD

FORMATION	CONTENT	FROM	TO	SIZE	PUT IN	PULLED OUT
				8 5/8	156'	None

Describe in detail the manner in which the well was plugged, indicating where the mud fluid was placed and the method or methods used in introducing it into the hole. If cement or other plugs were used, state the character of same and depth placed, from _____ feet to _____ feet for each plug set.

Gunned pits to raise weight--layed down half drill pipe--circulated 30 minutes
layed down rest drill pipe--set solid rock bridge @ 156' with 15 sacks
cement through five joints drill pipe--top plug with 35' with five sacks cement.

(If additional description is necessary, use BACK of this sheet)

Name of Plugging Contractor Salina Drilling Corporation, Inc.
Address Box #566, Salina, Kansas.

STATE OF Kansas, COUNTY OF Sedgwick, ss.
H.C. Bennett (owner) or (owner or operator) of the above-described well, being first duly sworn on oath, says: That I have knowledge of the facts, statements, and matters herein contained and the log of the above-described well as filed and that the same are true and correct. So help me God.

(Signature) H.C. Bennett
Drawer #31, Augusta, Kansas
(Address)

SUBSCRIBED AND SWORN TO before me this 8 day of July, 19 54

My commission expires May 11, 1957

H.M. Pichering
Notary Public.

PLUGGING
FILE SEC 19 T 21 R 6 W
BOOK PAGE 46 LINE 14

RECEIVED
STATE CORPORATION COMMISSION
7-9-54
JUL 9 1954
CONSERVATION DIVISION
Wichita, Kansas

ROTARY DRILLER'S LOG

Johnson #1

Elevation: 1640 DF 1637 GL

Legal Description: NE NE NW
Sec. 19, Twp. 21, Range 6W,
Rice County, Kansas.

"Casing Record"
156' Surface 8 5/8" cemented with
150 sacks Reg. 3% CC 1% Floseal

Operator: Gould & Bennett
5830 N. Broadway,
Wichita, Kansas.

Contractor: Salina Drilling Corp., Inc.
Box #566,
Salina, Kansas.

Well Commenced: 6-20-54

GEOLOGIST: I. N. Roberts
212 Derby Building,
Wichita, Kansas.

Well Completed: 7-3-54

Cellar -----	8
Sand and Clay-----	70
Red Bed-----	156
Red Bed Shale -----	450
Shale and Shells-----	1025
Salt, shale and Lime-----	1150
Shale and Lime -----	1220
Lime-----	1480
Lime and shale-----	2765
Shale and Lime-----	2415
Lime and shale-----	2660
Lime -----	2800
Lime and shale-----	3482
Conglomerate-----	3509
Mississippi -----	3530


GEOLOGIST TOPS (FROM KELLY BUSHING)

Conglomerate -----	3482
Mississippi -----	3509
Total Depth -----	3530

The above Rotary Driller's log is complete and correct to the best of my knowledge.

SALINA DRILLING CORPORATION, INC.

Loren S. Hallam

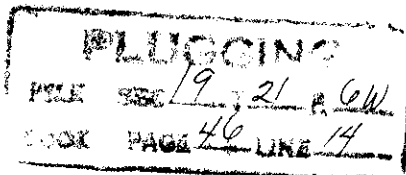

COPIED