


WELL PLUGGING RECORD

Give All Information Completely
 Make Required Affidavit

COUNTY Hodgeman SEC. 20 TWP. 23S RGE. 22W E 1/4
 Location as in quarters or footage from lines:
C W/2 W/2 NE

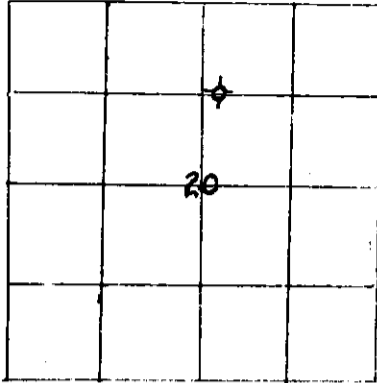

Locate Well
 correctly on above
 Section Platt.

Lease Owner American Energies Corporation
 Lease Name Gleason Well No. 2
 Office Address 575 Fourth Financial Center, Wichita, KS 67202
 Character of Well (Completed as Oil, Gas or Dry Hole): dry hole
 Date Well Completed December 2, 1981
 Application for plugging filed December 2, 1981
 Plugging commenced December 2, 1981
 Plugging completed December 2, 1981
 Reason for abandonment of well or producing formation _____

Was permission obtained from the Conservation Division or it's
 Agent's before plugging was commenced? yes

Name of Conservation Agent who supervised plugging of this well Steve Durantt
 Producing formation _____ Depth to top _____ bottom _____ T.D. 4660

Show depth and thickness of all water, oil and gas formations.

OIL, GAS OR WATER RECORDS

Casing Record

Formation	Content	From	To	Size	Put in	Pulled Out
Surface	Shale	0	293	8-5/8"	290'	none
	cemented w/225 sx	60/40	posmix,	2%gel, 3% cc,		
	plug down at 5 p.m.	11-20-81	by Sun.			

Describe in detail the manner in which the well was plugged, indicating where the mud fluid was placed and the method or methods used in introducing it into the hold. If cement or other plugs were used, state the character of same and depth placed, from _____ feet to _____ feet for each plug set.

Plugged as follows:
 125 sx 50/50 pos, 4%gel, 3% cc
 1 st plug @ 840' w/70 sx
 2nd plug @ 270' w/40 sx
 3rd plug @ 40' w/10 sx & solid plug
 By Sun, Completed 11:45 p.m. 12-2-81.

(If additional description is necessary, use BACK of this sheet)

Name of Plugging Contractor Husky Drilling Co., Inc.

STATE OF KANSAS COUNTY OF SEDGWICK, ss.
Jon T. Williams, Jr. (employee of owner) or (owner or operator) of the
 above-described well, being first duly sworn on oath, says: That I have knowledge of the
 facts, statements, and matters herein contained and the log of the above-described well as
 filed and that the same are true and correct. So help me God.

(Signature) [Signature]
200 E. 9th St, Suite 500, Wichita, KS
 (Address)



SUBSCRIBED AND SWORN TO before me this 2nd day of December, 1981

Geraldine Stewart
 Geraldine Stewart, Notary Public.

Commission expires: January 14, 1985

DEC - 9 1981
 12-9-81
 CONSERVATION DIVISION
 Wichita, Kansas