


15-101-000 73-0000

SKELLY OIL COMPANY

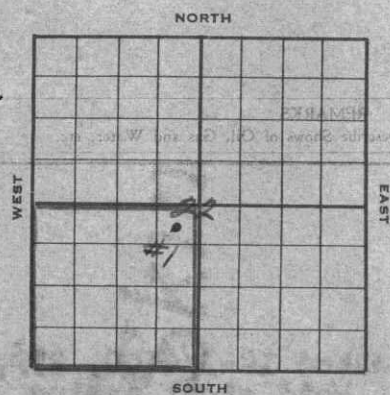

Well Record

Lease Name and No. G. Tagerquist Well No. 1 Elev. 2064' DP
Lease Description SW/4 Sec. 22-100-30N,
Lane County, Kansas
Location made March 27 1945 by R. S. Templer
330 feet from North line 330 feet from East line SW/4
feet from South line feet from West line of Sec. 22
Work com'd Mar. 31 1945 Rig comp'd Apr. 9 1945 Drlg. com'd Apr. 12 1945 Drlg. comp'd May 15 1945
Rig Contractor H & T. Drilling Company
Drilling Contractor H & T Drilling Company, Great Bend, Kansas
Rotary Drilling from Top to 5015' Cable Tool Drilling from to
Commenced Producing DRY HOLE 19 Initial Prod. before shot or acid Bbls.
Initial Prod. after shot or acid Bbls.
Dry Gas Well Press Volume Cu. ft.
Casing Head Gas Pressure Volume Cu. ft.
Braden Head (Size) Gas Pressure Volume Cu. ft.
Braden Head (Size) Gas Pressure Volume Cu. ft.
PRODUCING FORMATION DRY HOLE Top Bottom TOTAL DEPTH 5015'
(Name)

CASING RECORD

Size	Wt.	Thds.	Where Set	PULLED OUT			LEFT IN			KIND	Cond'n	CEMENTING	
				Jts.	Feet	In.	Jts.	Feet	In.			Sacks Used	Method Employed
10-3/4" OD 27.5 LBS			1195'				30	1195	0	Arco SW	A	550	Halliburton
(10-3/4" OD Casing set 6' in cellar)													

Liner Set at Length Perforated at
Liner Set at Length Perforated at
Packer Set at Size and Kind
Packer Set at Size and Kind

SHOT OR ACID TREATMENT RECORD

	FIRST		SECOND		THIRD		FOURTH	
Date								
Acid Used								
Size Shot		Gals. Qts.		Gals. Qts.		Gals. Qts.		Gals. Qts.
Shot Between	Ft. and	Ft.	Ft. and	Ft.	Ft. and	Ft.	Ft. and	Ft.
Size of Shell								
Put in by (Co.)								
Length anchor								
Distance below Cas'g								
Damage to Casing or Casing Shoulder								

SIGNIFICANT GEOLOGICAL FORMATIONS

NAME	Top	Bottom	GAS		OIL		REMARKS
			From	To	From	To	
Lansing Line	4924'						
Mississippi Line	4544'				4544'	4550'	oil, oil saturation
Arbuckle Line	4283'						

PLUGGING

FILE 22 18 R 30W
BOOK PAGE 13 LINE 9

5-25-45

CLEANING OUT RECORDS

	DATE COMMENCED	DATE COMPLETED	PROD. BEFORE	PROD. AFTER	REMARKS
1st					See Reverse for other details.
2nd					" " " " "
3rd					" " " " "
4th					" " " " "

PLUGGING BACK AND DEEPENING RECORDS

	Date Commenced	Date Completed	No. Feet Plugged Back or Deepened	Prod. Before	Prod. After	REMARKS
1st						See Reverse for other details.
2nd						" " " " "
3rd						" " " " "
4th						" " " " "

(See Reverse for Record of Formation)