


15.165-01847-0000  
le

STATE OF KANSAS  
STATE CORPORATION COMMISSION  
Give All Information Completely  
Make Required Affidavit  
Mail or Deliver Report to:  
Conservation Division  
State Corporation Commission  
511 No. Broadway  
Wichita, Kansas

### WELL PLUGGING RECORD

Rush County. Sec. 11 Twp. 16S Rge. 18 (E) W (W)  
Location as "NE/CNWxSWx" or footage from lines NE NE NE  
Lease Owner Terrel Drilling & Producing  
Lease Name Werth Well No. 1  
Office Address Russell, Kansas  
Character of Well (completed as Oil, Gas or Dry Hole) Dry Hole  
Date well completed February 3, 1962  
Application for plugging filed February 3, 1962  
Application for plugging approved February 3, 1962  
Plugging commenced February 3, 1962  
Plugging completed February 3, 1962  
Reason for abandonment of well or producing formation Dry Hole  
If a producing well is abandoned, date of last production 19  
Was permission obtained from the Conservation Division or its agents before plugging was commenced? Yes

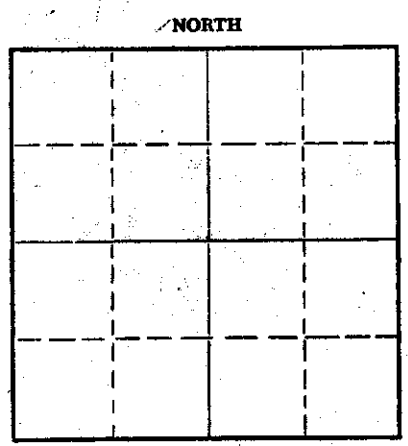

Name of Conservation Agent who supervised plugging of this well Eldon Petty  
Producing formation \_\_\_\_\_ Depth to top \_\_\_\_\_ Bottom \_\_\_\_\_ Total Depth of Well 3547 Feet  
Show depth and thickness of all water, oil and gas formations.

OIL, GAS OR WATER RECORDS				CASING RECORD		
FORMATION	CONTENT	FROM	TO	SIZE	PUT IN	PULLED OUT

Describe in detail the manner in which the well was plugged, indicating where the mud fluid was placed and the method or methods used in introducing it into the hole. If cement or other plugs were used, state the character of same and depth placed, from \_\_\_\_\_ feet to \_\_\_\_\_ feet for each plug set.

Filled hole with mud, set plug and 1/2 sack hulls at 450 and pumped 35 sacks cement. Plug and 1/2 sack hulls at 150' and pumped 35 sacks cement, circulated cement from 60' to surface.

**RECEIVED**  
STATE CORPORATION COMMISSION  
2-20-62 FEB 20 1962  
CONSERVATION DIVISION  
Wichita, Kansas

(If additional description is necessary, use BACK of this sheet)  
Name of Plugging Contractor Terrel Drilling & Producing  
Address 754 East Wichita - Russell, Kansas

STATE OF KANSAS COUNTY OF RUSSELL, ss.  
Joe K. Branum (address of owner) of the above-described well, being first duly sworn on oath, says: That I have knowledge of the facts, statements, and matters herein contained and the log of the above-described well as filed and that the same are true and correct. So help me God.

(Signature) Joe K. Branum  
Russell, Kansas (Address)

SUBSCRIBED AND SWORN to before me this 15th day of February, 1962  
Mary Anne Branum Notary Public.  
My commission expires November 13, 1962

WELL LOG

OPERATOR: Terrel Drilling & Producing  
754 East Wichita  
Russell, Kansas

CONTRACTOR: Terrel Drilling & Producing  
754 East Wichita  
Russell, Kansas

LEASE: Werth (NE/4 NE/4 of 11-16-18)  
Rush County, Kansas

COMMENCED: January 12, 1962  
COMPLETED: February 3, 1962

WELL: No. 1

Location: NE NE NE

FORMATIONS & DEPTHS

Surface Clay & Shale	130	Shale & Lime	3140
Shale	525	Lime	3460
Sand	615	Shale & Lime	3510
Anhydrite	985	R. T. D.	3547
Shale & ?Shells	1250		
Shale & Lime	1980		
Lime & Shale	2450		

RECEIVED  
STATE CORPORATION COMMISSION


FEB 20 1962

CONSERVATION DIVISION  
Wichita, Kansas


STATE OF KANSAS

COUNTY OF RUSSELL ss

Joe K. Branum, Owner of Terrel Drilling & Producing, being first duly sworn on oath says: That I have knowledge of the facts, statements, and matters herein contained and the log of the above described well as filed and that the same are true and correct.

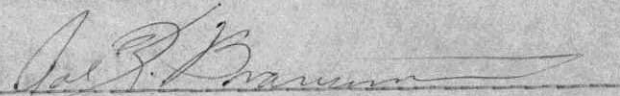  
Joe K. Branum

Subscribed and sworn before me this 15th day of February, 1962

  
Notary Public Russell, County

My Commission Expires: November 13, 1963.