


STATE OF KANSAS
STATE CORPORATION COMMISSION

WELL PLUGGING RECORD

Give All Information Completely
Make Required Affidavit
Mail or Deliver Report to
Conservation Division
State Corporation Comm.
245 North Water
Wichita, KS 67202

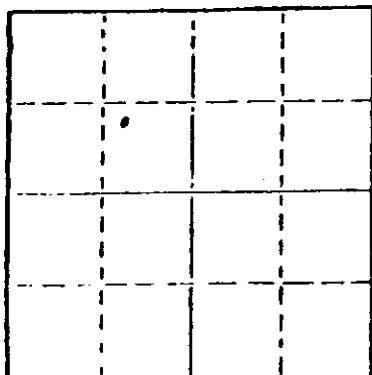

Locate well correctly on above
Section Plat

Rush County. Sec. 11 Twp. 16 Rge. 18 W E/W
Location as "NE/CNW $\frac{1}{4}$ SW $\frac{1}{4}$ " or footage from lines
NE SE NW/4
Lease Owner J & C Oil Company
Lease Name F. Urban Well No. 1
Office Address Motel at 20th & Vine, Hays, KS 67601
Character of Well (Completed as Oil, Gas or Dry Hole)

Dry Hole

Date Well completed 10-14 1978
Application for plugging filed 10-14 1978
Application for plugging approved 10-14 1978
Plugging commenced 10-14 1978
Plugging completed 10-14 1978
Reason for abandonment of well or producing formation

Dry Hole

If a producing well is abandoned, date of last production 19

Was permission obtained from the Conservation Division or its agents before plugging was commenced? Yes

Name of Conservation Agent who supervised plugging of this well Leo Massey
Producing formation Depth to top Bottom Total Depth of Well 3604'
Show depth and thickness of all water, oil and gas formations.

OIL, GAS OR WATER RECORDS

CASING RECORD

FORMATION	CONTENT	FROM	TO	SIZE	PUT IN	PULLED OUT
				8 5/8"	1148'	NONE

Describe in detail the manner in which the well was plugged, indicating where the mud fluid was placed and the method or methods used in introducing it into the hold. If cement or other plugs were used, state the character of same and depth placed, from feet to feet for each plug set.

Hole plugged w/40 sks. @ 420'

10 sks. @ 40'

50-50 Pozmix, 2% Gel. By Sun Cementing CO. INC.

Job completed @ 5:00 a.m.

STATE CORPORATION COMMISSION

OCT 23 1978

10-23-78

CONSERVATION DIVISION
Wichita, Kansas

(If additional description is necessary, use BACK of this sheet)

Name of Plugging Contractor Allen Drilling Company
P. O. Box 1389, Great Bend, KS 67530

STATE OF Kansas COUNTY OF Barton, ss.
Allen Drilling (employee of owner) or (owner or operator)
of the above-described well, being first duly sworn on oath, says: That I have knowledge of the facts, statements, and matters herein contained and the log of the above-described well as filed and that the same are true and correct. So help me God.

(Signature)

P. O. Box 1389, Great Bend, KS 67530
(Address)

SUBSCRIBED AND SWORN TO before me this 17th day of October, 19 78

Notary Public.

My commission expires 1-28-1980

DRILLER'S WELL LOG

DATE COMMENCED: 10-6-78
DATE COMPLETED: 10-14-78

J & C Oil Company
F. Urban #1
NE SE NW/4, Sec. 11-16-18,
Rush County, Kansas

ELEVATIONS 2017' K.B.
2012' G.L.
2014' D.F.
FORMATION DATA

1136- ' Anhydrite
2941-2960' Shale and Sand
2960-3251' Lime
3251-3256' Shale
3256-3270' Lime
3270-3303' Lime
3303-3525' Lime
3525-3536' Lime and Shale
3536-3554' Shale, Lime, Chert and Sand
3554-3572' Conglomerate Sand
3572-3597' Cherty Sand
3597-3604' Dolomite
3604' RTD

Anhydrite	1136	+ 881
Severy	2941	- 924
Topeka	2960	- 943
Heebner	3251	-1234
Toronto	3270	-1253
Lansing	3303	-1286
Base Kansas City	3525	-1508
Conglomerate	3536	-1519
Conglomerate Sand	3554	-1537
Cherty Conglomerate	3572	-1552
Reworked Arbuckle	3597	-1580
RTD	3604	-1587

SURFACE PIPE:

Ran 28 Jts. New 24# 8 5/8" Casing.
Tally 1141'. Set @ 1148' w/250 sks.
60-40 Pozmix, 2% Gel, 3% c.c. and
200 sks. Common, 2% Gel, 3% c.c.
By Sun Cementing. P.D. @ 1:15 p.m.
Cement circulated.

PLUGGING:

Hole plugged w/40 sks. @ 420'
10 sks. @ 40'
50-50 Pozmix, 2% Gel.
By Sun Cementing. Job completed
@ 5:00 a.m. Orders by Leo Massey,
Hays, Kansas

RECEIVED
STATE CORPORATION COMMISSION

AFFIDAVIT

NOV - 8 1978

CONSERVATION DIVISION
Wichita, Kansas

STATE OF KANSAS)
COUNTY OF BARTON) ss.

DALE L. SMITH, of lawful age, does swear and state that the facts and statements herein contained are true and correct to the best of his knowledge.

X Dale Smith

Subscribed and sworn to before me this 18th day of October 1978.

Gloria Nichols
(Notary Public)

My commission Expires: 1-28-1980

