


Give All Information Completely
Make Required Affidavit
Mail or Deliver Report to
Conservation Division
State Corporation Commission
800 Biting Building
Wichita, Kansas

OR

Strike out upper line
when reporting plug-
ging off formations.

FORMATION PLUGGING RECORD

NORTH

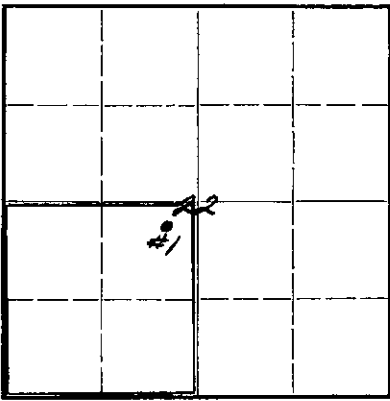

Locate well correctly on above
Section Plat

Lane _____ County. Sec. 22 Twp. 18S Rge. (E) 30 (W)
Location as "NE $\frac{1}{4}$ NW $\frac{1}{4}$ SW $\frac{1}{4}$ " or footage from lines. NE $\frac{1}{4}$ NE $\frac{1}{4}$ SW $\frac{1}{4}$
Lease Owner. Skelly Oil Company
Lease Name. Gertrude Fagerquist Well No. 1
Office Address. Box 391, Hutchinson, Kansas
Character of Well (completed as Oil, Gas or Dry Hole) Dry Hole
Date well completed. May 15 19 45
Application for plugging filed. May 16 (written) 19 45
Application for plugging approved. May 15 (verbally) 19 45
Plugging commenced. May 15 19 45
Plugging completed. May 15 19 45
Reason for abandonment of well or producing formation.

If a producing well is abandoned, date of last production. 19_____
Was permission obtained from the Conservation Division or its agents before plugging was com-
menced? Yes

Name of Conservation Agent who supervised plugging of this well. H. W. Kerr
Producing formation. _____ Depth to top. _____ Bottom. _____ Total Depth of Well. 5015 Feet
Show depth and thickness of all water, oil and gas formations.

OIL, GAS OR WATER RECORDS


CASING RECORD

Formation	Content	From	To	Size	Put In	Pulled Out
Lansing Lime	Dry	3924'		10-3/4"OD	1195'	None
Mississippi Lime	Dry	4544'				
Arbuckle Lime	Dry	4983'				

Describe in detail the manner in which the well was plugged, indicating where the mud fluid was placed and the method or methods used in
introducing it into the hold. If cement or other plugs were used, state the character of same and depth placed, from _____ feet to
_____ feet for each plug set.

45 sacks of cement and drilling mud 5015' to 1195'
Wood plug and 50 sacks cement 1195' to 1095'
Mud laden fluid 1095' to 100'
Wood plug and 50 sacks cement 100' to 6'
Surface soil and rock 6' to 0.

5-25-45

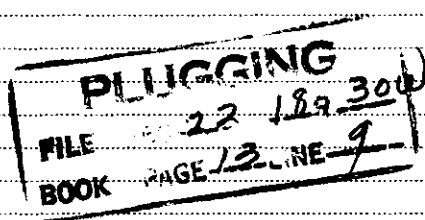

(If additional description is necessary, use BACK of this sheet)

Correspondence regarding this well should be addressed to. Skelly Oil Company
Address. Box 391, Hutchinson, Kansas

STATE OF KANSAS, COUNTY OF RENO, SS.
H. E. Wamsley (employee of owner ~~SKELLY OIL COMPANY~~) of the above-described well,
being first duly sworn on oath, says: That I have knowledge of the facts, statements, and matters herein contained and the log of the above-
described well as filed and that the same are true and correct. So help me God.

(Signature)

Box 391, Hutchinson, Kansas
(Address)

SUBSCRIBED AND SWORN to before me this 24th day of May, 1945.

My commission expires August 4, 1945.

Notary Public.