

K-1165-21126-0000

STATE OF KANSAS
STATE CORPORATION COMMISSION

FORM CP-4

WELL PLUGGING RECORD

Give All Information Completely
Make Required Affidavit
Mail or Deliver Report to
Conservation Division
State Corporation Comm.
200 Colorado Derby Bldg.
202 W. 1st St.
Wichita, KS 67202

Rush County Sec. 8 Twp. 16S Rge. 19W
Location as "NE/CNW/SW" or footage from lines _____

SE NE SW

Lease Owner Walters & Walters

Lease Name Elmore Ryan Well No. #2

Office Address 5924 Royal Road #155 Dallas, Texas 75230

Character of Well (Completed as Oil, Gas or Dry Hole) _____

Dry Hole

Date Well completed 9-25 1983

Application for plugging filed 9-25 1983

Application for plugging approved 9-25 1983

Plugging commenced 4:00 A.M. 9-25 1983

Plugging completed 7:00 A.M. 9-25 1983

Reason for abandonment of well or producing formation _____
No Commercial Production


If a producing well is abandoned, date of last production _____ 19____

Was permission obtained from the Conservation Division or its agents before plugging was commenced? Yes

Name of Conservation Agent who supervised plugging of this well Marion Schmidt

Producing formation _____ Depth to top _____ Bottom _____ Tl. Depth of Well _____

Show depth and thickness of all water, oil and gas formations.

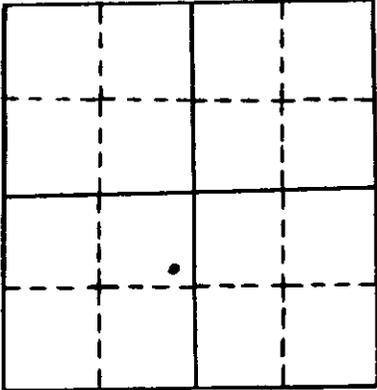

locate well correctly
on above
Section Plot

OIL, GAS OR WATER RECORDS

CASING RECORD

FORMATION	CONTENT	FROM	TO	SIZE	PUT IN	PULLED OUT
Surface Casing	60-40pos	0'	201.75'	8 5/8"	201.75'	0'

Describe in detail the manner in which the well was plugged, indicating where the mud fluid was placed and the method or methods used in introducing it into the hold. If cement or other plugs were used, state the character of same and depth placed, from _____ feet to _____ feet for each plug set.

Plug #1 1350' with 50sxs

Plug #2 660' with 50sxs

Plug #3 240' with 40sxs

Plug #4 40' with 10sxs

10sxs in rathole

Total _____ 160sxs 60-40pos 3%cc 2%gel

P.D. @ 7:00 A.M. 9-25-83

(If additional description is necessary, use BACK of this sheet)

Name of Plugging Contractor Pioneer Drilling Company
308 West Mill Plainville, KS 67663

STATE OF Texas COUNTY OF Dallas, ss.

G. C. Walters, Jr. (employee of owner) or (owner or operator) of the above described well, being first duly sworn on oath, says: That I have knowledge of the facts, statements, and data herein contained and the log of the above described well is filed and that the same are true and correct. So help me God.

(Signature) G. C. Walters, Jr.

(Address) _____

RECEIVED
NOV 7 1983
STATE CORPORATION COMMISSION
Wichita, Kansas

SUBSCRIBED AND SWORN TO before me this 3rd day of November, 1983

My commission expires June 15, 1985

Susan Lynn Martin
Notary Public