


WELL PLUGGING RECORD

STATE OF KANSAS
STATE CORPORATION COMMISSION
Give all Information Completely
Make Required Affidavit
Mail or Deliver Report to:
Conservation Division
State Corporation Commission
211 No. Broadway
Wichita, Kansas

Rush County, Sec. 29 Twp. 18 Rge. 16 (E) W (W)

Location as "NE/CNW/SW" or footage from lines NE NE SE
Lease Owner Murfin Drilling Co.
Lease Name Lohrey Well No. 1
Office Address Wichita, Kans.
Character of Well (completed as Oil, Gas or Dry Hole) Oil
Date well completed _____ 19____
Application for plugging filed June 27 19 62
Application for plugging approved July 2 19 62
Plugging commenced July 4 8:00 A M 19 62
Plugging completed July 7 4:00 P M 19 62
Reason for abandonment of well or producing formation Depleted

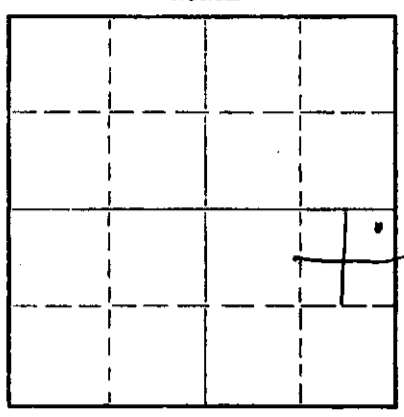

Locate well correctly on above Section Plat

If a producing well is abandoned, date of last production June 1 19 62
Was permission obtained from the Conservation Division or its agents before plugging was commenced? Yes

Name of Conservation Agent who supervised plugging of this well Eldon Petty
Producing formation Arb Depth to top _____ Bottom _____ Total Depth of Well 3682 Feet
Show depth and thickness of all water, oil and gas formations.

OIL, GAS OR WATER RECORDS

CASING RECORD

FORMATION	CONTENT	FROM	TO	SIZE	PUT IN	PULLED OUT
				8 5/8	1097'	none
				5 1/2	3682	2880

Describe in detail the manner in which the well was plugged, indicating where the mud fluid was placed and the method or methods used in introducing it into the hole. If cement or other plugs were used, state the character of same and depth placed, from _____ feet to _____ feet for each plug set.

Plugged back with sand to 3650' mix and dumped 4 sx cem from 3650 to 3618 pulled 2880 ft 5 1/2 csg, filled hole with mud to 480' set rock bridge from 480 to 455 filled hole with ready mix concrete to base of cellar.

RECEIVED
STATE CORPORATION COMMISSION
JUL 31 1962
7-31-62
CONSERVATION DIVISION
Wichita, Kansas

(If additional description is necessary, use BACK of this sheet)

Name of Plugging Contractor Ace Pipe Pulling Co License No 2
Address Great Bend, Kansas.

STATE OF Kansas COUNTY OF Sedgewick ss.
Ed Murfin (employee of owner) or (owner or operator) of the above-described well, being first duly sworn on oath, says: That I have knowledge of the facts, statements, and matters herein contained and the log of the above-described well as filed and that the same are true and correct. So help me God.

(Signature) [Signature]
617 Union Center Wichita, Kansas (Address)

SUBSCRIBED AND SWORN TO before me this 12th day of July, 19 62

My commission expires June 14, 1964

May Paul Palmer
Notary Public.