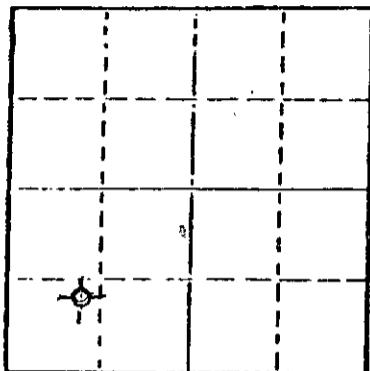


15007-212570000

FORM CP-4

STATE OF KANSAS  
STATE CORPORATION COMMISSION

Give All Information Completely  
Make Required Affidavit  
Mail or Deliver Report to  
Conservation Division  
State Corporation Comm.  
245 North Water  
Wichita, KS 67202

Locate well correctly on above  
Section Plot

## WELL PLUGGING RECORD

Barber County. Sec. 15 Twp. 34S Rge. 11 E/W  
Location as "NE/CNW 1/4 SW 1/4" or footage from lines

990 FWL &amp; 990 FSL of SW/4

Lease Owner C.E. Kimmell

Lease Name Medicine River Ranch Well No. 1

Office Address Milam Building - San Antonio, TX 78205

Character of Well (Completed as Oil, Gas or Dry Hole)

Dry Hole

Date Well completed 9/21/1981

Application for plugging filed 19

Application for plugging approved 19

Plugging commenced September 21 1981

Plugging completed September 21 1981

Reason for abandonment of well or producing formation

Dry Hole

If a producing well is abandoned, date of last production

19

Was permission obtained from the Conservation Division or  
its agents before plugging was commenced? yes

Name of Conservation Agent who supervised plugging of this well Maurice V. Leslie  
Producing formation Depth to top Bottom Total Depth of Well 4605  
Show depth and thickness of all water, oil and gas formations.

## OIL, GAS OR WATER RECORDS

## CASING RECORD

| FORMATION | CONTENT | FROM | TO | SIZE | PUT IN | PULLED OUT |
|-----------|---------|------|----|------|--------|------------|
|           |         |      |    |      |        |            |
|           |         |      |    |      |        |            |
|           |         |      |    |      |        |            |
|           |         |      |    |      |        |            |

Describe in detail the manner in which the well was plugged, indicating where the mud fluid was placed and the method or methods used in introducing it into the hole. If cement or other plugs were used, state the character of same and depth placed, from 850 feet to  
40 feet for each plug set. Plug @ 850' w/50 sks common - plug set @ 300'  
w/40 sks. - plug set @ 40' w/100 sks

(If additional description is necessary, use BACK of this sheet)

Name of Plugging Contractor Reynolds Drilling Co., Inc.

STATE OF TexasCOUNTY OF Bexar

, ss.

(employee of owner) or (owner or operator)

of the above-described well, being first duly sworn on oath, says: That I have knowledge of the facts, statements, and matters herein contained and the log of the above-described well as filed and that the same are true and correct. So help me God.

(Signature)

1716 Milam Bldg, San Antonio, Tx. 78205

(Address)

SUBSCRIBED AND SWORN TO before me this 12th day of November, 1981

Notary Public.

CONSTANCE M. HUTCHINSON

Notary Public, Bexar County, Texas

My commission expires, 10/31/84

# KANSAS DRILLERS LOG


API No. 15 — 007 — 21257-0000

S. 15 T. 34S R. 11 XX  
W

Loc. 990 FWL & 990 FSL of SW/4

County Barber

640 Acres  
N

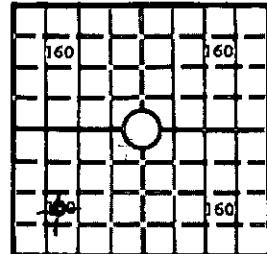

Locate well correctly

Elev.: Gr. 1331

DF 1342 KB

|   |                        |               |                        |
|---|------------------------|---------------|------------------------|
| Operator                                |                        | C.E. KIMMELL  |                        |
| Address                                 |                        |               |                        |
| Milam Building San Antonio, Texas 78205 |                        |               |                        |
| Well No.                                | Lease Name             |               |                        |
| 1                                       | Medicine River Ranch   |               |                        |
| Footage Location                        |                        |               |                        |
| 990                                     | feet from (E) (S) line | 990           | feet from (E) (W) line |
| Principal Contractor                    |                        | Geologist     |                        |
| Reynolds Drilling Co., Inc.             |                        | C.E. Kimmell  |                        |
| Spud Date                               |                        | Total Depth   | P.B.T.D.               |
| 9/08/81                                 |                        | 4605'         |                        |
| Date Completed                          |                        | Oil Purchaser |                        |

## CASING RECORD

Report of all strings set—surface, intermediate, production, etc.

| Purpose of string | Size hole drilled | Size casing set<br>(in O.D.) | Weight lbs/ft. | Setting depth | Type cement | Sacks | Type and percent<br>additives |
|-------------------|-------------------|------------------------------|----------------|---------------|-------------|-------|-------------------------------|
| SURFACE           | 7 7/8"            | 8 5/8"                       |                | 319'          | COMMON      | 175   | 3% c.c.                       |
|                   |                   |                              |                |               |             |       |                               |
## LINER RECORD

## PERFORATION RECORD

| Top, ft. | Bottom, ft. | Sacks cement | Shots per ft. | Size & type | Depth interval |
|----------|-------------|--------------|---------------|-------------|----------------|
|          |             |              |               |             |                |
|          |             |              |               |             |                |

## TUBING RECORD

| Size | Setting depth | Packer set at |
|------|---------------|---------------|
|      |               |               |

## ACID, FRACTURE, SHOT, CEMENT SQUEEZE RECORD

| Amount and kind of material used                        |  | Depth interval treated |
|---|--|------------------------|
| WICHITA, KANSAS<br>CONSERVATION DIVISION<br>NOV 16 1981 |  |                        |
| STATE CORPORATION COMMISSION                            |  |                        |
| RECEIVED  |  |                        |
|   |  |                        |

## INITIAL PRODUCTION

| Date of first production                           | Producing method (flowing, pumping, gas lift, etc.) |                       |                |                       |
|--|---|-----------------------|----------------|-----------------------|
| RATE OF PRODUCTION<br>PER 24 HOURS                 | Oil<br>bbls.  | Gas<br>MCF            | Water<br>bbls. | Gas-oil ratio<br>CFPB |
| Disposition of gas (vented, used on lease or sold) |   | Producing interval(s) |                |                       |

**INSTRUCTIONS:** As provided in KCC Rule 82-2-125, within 90 days after completion of a well, one completed copy of this Drillers Log shall be transmitted to the State Geological Survey of Kansas, 4150 Monroe Street, Wichita, Kansas 67209. Copies of this form are available from the Conservation Division, State Corporation Commission, 3830 So. Meridian (P.O. Box 17027), Wichita, Kansas 66217. Phone AC 316-522-2206. If confidential custody is desired, please note Rule 82-2-125. Drillers Logs will be on open file in the Oil and Gas Division, State Geological Survey of Kansas, Lawrence, Kansas 66044.

Operator

C.E. Kimmell

15-007-21257-0000

DESIGNATE TYPE OF COMP.: OIL, GAS,  
DRY HOLE, SWDW, ETC.:

Well No.

1

Lease Name

Medicine River Ranch

Dry Hole

S 15 T 34 R 11 E W

## WELL LOG

Show all important zones of porosity and contents thereof; cored intervals, and all drill-stem tests, including depth interval tested, cushion used, time tool open, flowing and shut-in pressures, and recoveries.

SHOW GEOLOGICAL MARKERS, LOGS RUN,  
OR OTHER DESCRIPTIVE INFORMATION.

| FORMATION DESCRIPTION, CONTENTS, ETC. | TOP  | BOTTOM | NAME | DEPTH |
|---------------------------------------|------|--------|------|-------|
| Surface                               | 239  | 496    |      |       |
| Shale                                 | 496  | 720    |      |       |
| Shale                                 | 720  | 978    |      |       |
| Shale                                 | 978  | 1260   |      |       |
| Shale                                 | 1260 | 1362   |      |       |
| Shale w/lime                          | 1362 | 1562   |      |       |
| Shale w/lime                          | 1562 | 1669   |      |       |
| Shale & Lime                          | 1669 | 1775   |      |       |
| Lime & Shale                          | 1775 | 1928   |      |       |
| Shale & Lime                          | 1928 | 2142   |      |       |
| Shale & Lime                          | 2142 | 2306   |      |       |
| Shale w/lime                          | 2306 | 2486   |      |       |
| Shale                                 | 2486 | 2658   |      |       |
| Shale                                 | 2658 | 2853   |      |       |
| Shale                                 | 2853 | 2896   |      |       |
| Shale w/lime                          | 2896 | 3066   |      |       |
| Shale                                 | 3066 | 3186   |      |       |
| Shale                                 | 3186 | 3302   |      |       |
| Shale                                 | 3302 | 3390   |      |       |
| Shale w/lime                          | 3390 | 3551   |      |       |
| Lime w/shale                          | 3551 | 3687   |      |       |
| Lime                                  | 3687 | 3818   |      |       |
| Shale & Lime                          | 3818 | 3882   |      |       |
| Shale                                 | 3882 | 3996   |      |       |
| Lime & Shale                          | 3996 | 4069   |      |       |
| Shale & Lime                          | 4069 | 4237   |      |       |
| Lime & Shale                          | 4237 | 4352   |      |       |
| Lime w/shale                          | 4352 | 4447   |      |       |
| Lime w/shale                          | 4447 | 4515   |      |       |
| Shale                                 | 4515 | 4593   |      |       |
| Shale                                 | 4593 | 4592   |      |       |
| Shale                                 | 4592 | 4605   |      |       |

USE ADDITIONAL SHEETS, IF NECESSARY, TO COMPLETE WELL RECORD.

Date Received



Signature



Title

11-12-81

Date