


15-077-20200-0000

STATE OF KANSAS
STATE CORPORATION COMMISSION

Form CP-4

Give All Information Completely
Make Required Affidavit
Mail or Deliver Report to:
Conservation Division
State Corporation Commission
P. O. Box 17027
Wichita, Kansas 67217
NORTH

WELL PLUGGING RECORD

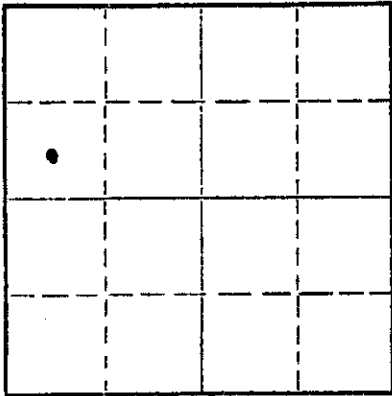

Locate well correctly on above
Section Plat

Harper County. Sec. 24 Twp. 32 Rge. 8 (E)W (W)
Location as "NE/CNW/SW" or footage from lines C SW NW
Lease Owner McCoy Petroleum Co.
Lease Name Kansas University Well No. 1
Office Address 502 Union Center, Wichita, Kansas 67202
Character of Well (completed as Oil, Gas or Dry Hole) Dry Hole
Date well completed 7-24 1973
Application for plugging filed 7-24 1973
Application for plugging approved 7-24 1973
Plugging commenced 7-24 1973
Plugging completed 7-24 1973
Reason for abandonment of well or producing formation Dry Hole

If a producing well is abandoned, date of last production 19
Was permission obtained from the Conservation Division or its agents before plugging was commenced? Yes

Name of Conservation Agent who supervised plugging of this well Russ Beiberstein
Producing formation _____ Depth to top _____ Bottom _____ Total Depth of Well _____ Feet
Show depth and thickness of all water, oil and gas formations.

OIL, GAS OR WATER RECORDS

CASING RECORD

FORMATION	CONTENT	FROM	TO	SIZE	PUT IN	PULLED OUT
Surface pipe		-0-	253	8 5/8"	253	None

Describe in detail the manner in which the well was plugged, indicating where the mud fluid was placed and the method or methods used in introducing it into the hole. If cement or other plugs were used, state the character of same and depth placed, from _____ feet to _____ feet for each plug set.

Filled hole with heavy mud.

- #1 plug set @ 240 Ft. with 25 sks. cement.
- #2 plug set @ 40 ft. with 10 sks. cement.
- #3 plug set in rat hole with 2 sks. cement.

RECEIVED
STATE CORPORATION COMMISSION
JUL 30 1973
CONSERVATION DIVISION
Wichita, Kansas

(If additional description is necessary, use BACK of this sheet)


Name of Plugging Contractor Sweetman Drilling, Inc.
Address Box 645, Great Bend, Kansas 67530

STATE OF Kansas, COUNTY OF Barton, ss.
Gary L. Hawk (employee of owner) or (owner or operator) of the above-described well, being first duly sworn on oath, says: That I have knowledge of the facts, statements, and matters herein contained and the log of the above-described well as filed and that the same are true and correct. So help me God.

(Signature) Gary L. Hawk
Box 645, Great Bend, Kansas 67530
(Address)

Subscribed and sworn to before me this 26th day of July, 1973
Mary Ann Schwaborn
Notary Public.

My commission expires 7-10-77

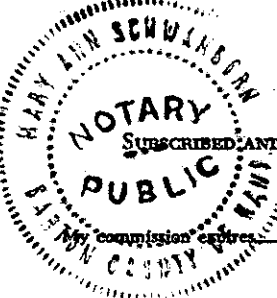

WELL LOG
Kansas University #1
C SW NW 24-32S-8W
Harper County, Kansas

Name of Operator: McCoy Petroleum Co.
502 Union Center Bldg.
Wichita, Kansas 67202

Date Completed: July 24, 1973

FROM	TO	
0	1110	Red bed and shale
1110	1380	Shale
1380	3677	Lime and shale
3677	3735	Sand
3735	3917	Lime and shale
3917	4475	K.C. Lime
4475	4490	Miss.
4490		Total Depth

RECEIVED
STATE CORPORATION COMMISSION
JUL 30 1973
CONSERVATION DIVISION
Wichita, Kansas

STATE OF KANSAS

COUNTY OF BARTON ss

Gary L. Hawk, Secretary of Sweetman Drilling, Inc., being first duly sworn on oath says: That I have knowledge of the facts, statements and matters herein contained and the log of the above described well as filed and that the same are true and correct.

Gary L. Hawk

Gary L. Hawk

Subscribed and sworn before me this 26th day of July, 1973.

Mary Ann Schwaborn

Notary Public Barton County

My Commission Expires 7-10-77

