

STATE OF KANSAS
STATE CORPORATION COMMISSION


WELL PLUGGING RECORD

Give All Information Completely
Make Required Affidavit
Mail or Deliver Report to:
Conservation Division
State Corporation Commission
800 Bittling Building
Wichita, Kansas

OR
FORMATION PLUGGING RECORD

Strike out upper line
when reporting plug-
ging off formations.

NORTH

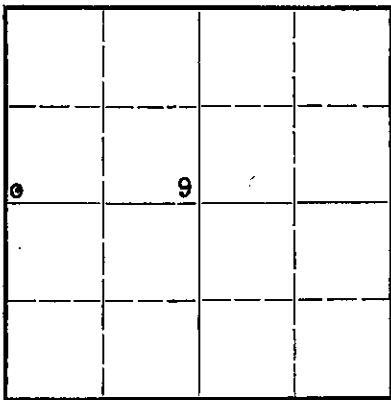

Locate well correctly on above
Section Plat

Rush County Sec. 9 Twp. 16s. Rge. (E) 18 (W)
Location as "NE $\frac{1}{4}$ NW $\frac{1}{4}$ SW $\frac{1}{4}$ " or footage from lines SW $\frac{1}{4}$ -SW $\frac{1}{4}$ -NW $\frac{1}{4}$
Lease Owner Sohio Petroleum Company
Lease Name Schneider Well No. 1
Office Address Box 609, Russell, Kansas
Character of Well (completed as Oil, Gas or Dry Hole) Dry Hole
Date well completed Sept. 15 1946
Application for plugging filed September 28 by telephone 1946
Application for plugging approved September 28 1946
Plugging commenced Sept. 29 1946
Plugging completed Oct. 4 1946
Reason for abandonment of well or producing formation Dry Hole

If a producing well is abandoned, date of last production Dry Hole 19
Was permission obtained from the Conservation Division or its agents before plugging was com-
menced? Yes, by telephone from H. Kerr, Great Bend, Kansas

Name of Conservation Agent who supervised plugging of this well H. Kerr, Great Bend, Kansas
Producing formation None Depth to top Bottom Total Depth of Well 3628 Feet
Show depth and thickness of all water, oil and gas formations.

OIL, GAS OR WATER RECORDS

CASING RECORD

Formation	Content	From	To	Size	Put In	Pulled Out
No commercial oil or gas shows from top of hole to depth				10 3/4	1169	None
						Cemented with 550' sacks of cement
				5 1/2	3568'	1385'
				Revd 10-12-46		Cemented with 100 sacks of cement

Describe in detail the manner in which the well was plugged, indicating where the mud fluid was placed and the method or methods used in introducing it into the hold. If cement or other plugs were used, state the character of same and depth placed, from feet to feet for each plug set.

Five sacks of Portland cement dumped at total depth, hole mudded to 250', fresh water plug set at 250' with 15 sacks of cement, hole mudded to top and capped with 10 sacks of Portland cement.

(If additional description is necessary, use BACK of this sheet)

Correspondence regarding this well should be addressed to Sohio Petroleum Company
Address Box 609, Russell, Kansas

STATE OF Kansas, COUNTY OF Russell, ss.
L. G. Manning (employee of owner) or (owner or operator) of the above-described well,
being first duly sworn on oath, says: That I have knowledge of the facts, statements, and matters herein contained and the log of the above-described well as filed and that the same are true and correct. So help me God.

(Signature) L. G. Manning
Box 609, Russell, Kansas
(Address)

SUBSCRIBED AND SWORN to before me this 11th day of October, 1946

My commission expires 1948

My commission expires

Bernie J. Smith
Notary Public.

15-165-08290-0000

CONTRACTOR'S VERIFIED LOG

Operator Sohio Petroleum Co. Farm Name Schneider Well No. 1
 Location SW/4 SW/4 NW/4 Section 9-16S-18W.
 Pool Name Wildcat County Rush State Kansas
 Commencement Date August 15th, 1946 Completion Date September 5th, 1946.

LOG OF WELL

Depth		Formation	Deviation from Vertical (Degrees)	Remarks
From	To			
0	50	Surface Rock & Clay		
50	130	Shale		
130	376	Shale & Shells		
376	518	Shale, Shells & Pyrite		
518	645	Sand		
645	675	Shale		
675	705	Sand		
705	840	Red Bed		
840	865	Shale		
865	990	Red Beds		
990	1010	Sand		
1010	1165	Red Beds & Shale	0°	Syfo at 1000' - Hole O.K.
1165	1206	Anhydrite		
1206	1390	Red Beds		
1390	1540	Shale & Shells	0°	Syfo at 1500' - Hole O.K.
1540	1750	Shale, Shells & Salt		
1750	1830	Shale & Shells		
1830	1865	Lime & Shale		
1865	2190	Sandy Lime	0°	Syfo at 2000' - Hole O.K.
2190	2210	Sandy Lime & Shale		
2210	2255	Lime		
2255	2285	Lime & Shale		
2285	2305	Lime & Shale		
2305	2325	Lime		
2325	2340	Sandy Lime & Shale		
2340	2385	Lime		
2385	2445	Lime & Red Rock		
2445	2475	Lime		
2475	2480	Shale & Lime		
2480	2523	Lime, Shale & Red Rock	0°	Syfo at 2500' - Hole O.K.
2523	2531	Lime		
2531	2650	Lime & Shale		
2650	2780	Shale & Lime		
2780	2830	Lime & Shale		
2830	2920	Shale & Lime		
2920	2963	Lime & Shale	0°	Syfo at 3000' - Hole O.K.
2963	3015	Shale & Lime		
3015	3559	Lime & Shale		
3559	3571	Conglomerate		
3571	3574	Sand		Syfo at 3500' - Hole O.K.

