


STATE OF KANSAS
STATE CORPORATION COMMISSION

Give All Information Completely
Make Required Affidavit
Mail or Deliver Report to:
Conservation Division
State Corporation Commission
211 No. Broadway
Wichita, Kansas

K.165-02020-0000

WELL PLUGGING RECORD

NORTH

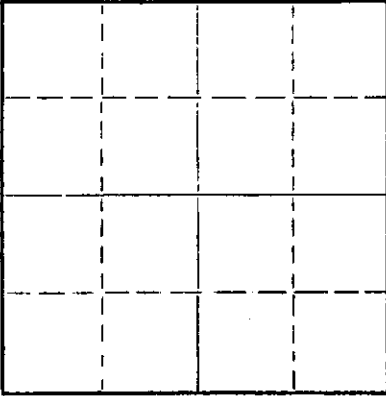

Locate well correctly on above
Section Plat

Rush County. Sec. 7 Twp. 16S Rge. 18W (X) (W)
Location as "NE/CNW/SW" or footage from lines. C NE NE
Lease Owner. Frontier Oil Company
Lease Name Warth Well No. #1
Office Address 580 Fourth Nat'l. Bank Bldg., Wichita, Kansas
Character of Well (completed as Oil, Gas or Dry Hole) D&A
Date well completed November 2 19 61
Application for plugging filed November 2 19 61
Application for plugging approved November 2 19 61
Plugging commenced November 2 19 61
Plugging completed November 2 19 61
Reason for abandonment of well or producing formation D & A

If a producing well is abandoned, date of last production 19
Was permission obtained from the Conservation Division or its agents before plugging was commenced? Yes

Name of Conservation Agent who supervised plugging of this well Eldon Petty
Producing formation _____ Depth to top _____ Bottom _____ Total Depth of Well _____ Feet
Show depth and thickness of all water, oil and gas formations.

OIL, GAS OR WATER RECORDS

CASING RECORD

FORMATION	CONTENT	FROM	TO	SIZE	PUT IN	PULLED OUT
				8 5/8	295	-0-

Describe in detail the manner in which the well was plugged, indicating where the mud fluid was placed and the method or methods used in introducing it into the hole. If cement or other plugs were used, state the character of same and depth placed, from _____ feet to _____ feet for each plug set.

Fill hole w/heavy mud to 450.
Plug w/30 sx cement. Fill to
280 w/heavy mud. Plug w/30 sx
cement. Fill to 35' Plug w/
sx of hulls & 10 sx cement.

RECEIVED
STATE CORPORATION COMMISSION

NOV 17 1961

CONSERVATION DIVISION
Wichita, Kansas

(If additional description is necessary, use BACK of this sheet)

Name of Plugging Contractor Red Tiger Drilling Company
Address Box 173 -- Russell, Kansas

STATE OF KANSAS, COUNTY OF SEDGWICK, ss.

George A. Angle (owner or operator) of the above-described well, being first duly sworn on oath, says: That I have knowledge of the facts, statements, and matters herein contained and the log of the above-described well as filed and that the same are true and correct. So help me God.

(Signature)

George A. Angle

580 Fourth National Bank Bldg.
(Address)

SUBSCRIBED AND SWORN TO before me this 16th day of November, 19 61

Margie Head

My commission expires 11-17-62

Notary Public.

DRILLERS LOG

Werth No. 1

CASING RECORD: 8 5/8" @ 295
w/160 sx cement

COMPANY: Frontier Oil Company

CONTRACTOR: Red Tiger Drilling Co.

COMMENCED: October 22, 1961

COMPLETED: November 2, 1961

DESCRIPTION: C NE NE
7-16S-18W
Rush Co.,
Kansas

ELEVATION: 2029 DF
2032 RB

TOTAL DEPTH: 3642'

<u>FORMATION</u>	<u>FROM</u>	<u>TO</u>	<u>REMARKS</u>
Shale & Sand & Shale	0	295	
Shale Shells & Sand	295	600	
Shale	600	665	
Sand	665	885	
Shale	885	1189	
Anhydrite	1189	1230	
Shale & Shells	1230	1820	
Shale & Lime	1820	1920	
Lime	1920	2140	
Lime & Shale	2140	2445	
Lime	2445	2545	
Lime & Shale	2545	3330	
Lime	3330	3624	

RECEIVED
STATE CORPORATION COMMISSION
NOV 17 1961
CONSERVATION DIVISION
WICHITA, KANSAS

I certify that this is a true and correct copy of the above log to the best of my knowledge.

FRONTIER OIL COMPANY

George A. Angle
George A. Angle

Subscribed and sworn to before me this 16th day of November, 1961.

Mariane Shad
Notary Public

My Commission Expires:

11-17-62