


15.165-30085-0000

Give All Information Completely  
Make Required Affidavit  
Mail or Deliver Report to:  
Conservation Division  
State Corporation Commission  
211 No. Broadway  
Wichita, Kansas

WELL PLUGGING RECORD

NORTH

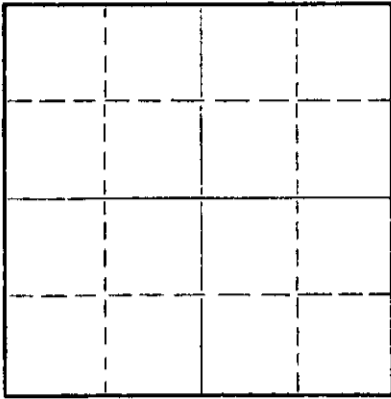

Locate well correctly on above  
Section Plat

Rush County. Sec. 8 Twp. 16S Rge. 18W (E) (W)  
Location as "NE/CNW/SE/SW" or footage from lines NE NW NW  
Lease Owner Omega Drilling, Inc. et al  
Lease Name Nora Benbow Well No. #1  
Office Address 427 Union Center, Wichita, Kansas  
Character of Well (completed as Oil, Gas or Dry Hole) Dry Hole  
Date well completed May 15 19 65  
Application for plugging filed May 15 19 65  
Application for plugging approved May 15 19 65  
Plugging commenced May 15 19 65  
Plugging completed May 15 19 65  
Reason for abandonment of well or producing formation Dry Hole

If a producing well is abandoned, date of last production \_\_\_\_\_ 19\_\_\_\_  
Was permission obtained from the Conservation Division or its agents before plugging was commenced? Yes

Name of Conservation Agent who supervised plugging of this well Eldon Petty  
Producing formation \_\_\_\_\_ Depth to top \_\_\_\_\_ Bottom \_\_\_\_\_ Total Depth of Well 3703 Feet  
Show depth and thickness of all water, oil and gas formations.

OIL, GAS OR WATER RECORDS

CASING RECORD

FORMATION	CONTENT	FROM	TO	SIZE	PUT IN	PULLED OUT

Describe in detail the manner in which the well was plugged, indicating where the mud fluid was placed and the method or methods used in introducing it into the hole. If cement or other plugs were used, state the character of same and depth placed, from \_\_\_\_\_ feet to \_\_\_\_\_ feet for each plug set.

Filled up surface to 300' with 125 sx Pozmix

RECEIVED  
STATE CORPORATION COMMISSION  
JUN 11 1965  
CONSERVATION DIVISION  
Wichita, Kansas

(If additional description is necessary, use BACK of this sheet)

Name of Plugging Contractor Halliburton Company  
Address Duncan, Oklahoma

STATE OF Kansas, COUNTY OF Sedgwick, ss.  
F. S. Woodside, Jr. (owner or operator) of the above-described

well, being first duly sworn on oath, says: That I have knowledge of the facts, statements, and matters herein contained and the log of the above-described well as filed and that the same are true and correct. So help me God.

(Signature) F. S. Woodside, Jr.  
427 Union Center, Wichita, Kansas  
(Address)

SUBSCRIBED AND SWORN TO before me this 20th day of May 1965

My commission expires January 8, 1968

Lois J. McCoy  
Notary Public.

## ROTARY DRILLING LOG

Operator: Omega Drilling, Inc. and  
Buttes Gas & Oil Co.  
#1 Nora Benbow  
NE NW NW Section 8-16S-18W  
Rush County, Kansas

Contractor: Omega Drilling, Inc.  
Commenced: May 4, 1965  
Completed: May 15, 1965  
Remarks: Set 8 5/8" Surface  
Casing @ 284' w/200 sx  
Posmix

Formations:

0 - 343	Shale and Lime
343 - 634	Shale and Sand
634 - 863	Dakota
863 - 1022	Shale and Shells
1022 - 1084	Shale and Shells
1084 - 1205	Shale
1205 - 1235	Anhydrite
1235 - 1390	Shale
1390 - 1900	Shale
1900 - 1976	Shale and Shells
1976 - 2114	Shale and Lime
2114 - 2350	Lime
2350 - 2860	Lime and Shale
2860 - 3190	Lime and Shale
3190 - 3285	Lime and Shale
3285 - 3348	Lime and Shale
3348 - 3486	Lime
3486 - 3533	Lime
3533 - 3611	Lime and Chert
3611 - 3615	Lime
3615 - 3625	Lime
3625 - 3667	Lime
3667 - 3703	Reagan Sand
3703 -	Rotary Total Depth

RECEIVED  
STATE CORPORATION COMMISSION

JUN 11 1965

CONSERVATION DIVISION  
Wichita, Kansas

We certify the above log is true and correct  
to the best of our knowledge and belief.

OMEGA DRILLING, INC.

*F. S. Woodside, Jr.*

F. S. Woodside, Jr.  
Executive Vice-President

Subscribed and sworn to before me, a Notary Public, in and for the State of  
Kansas, County of Sedgwick, this 29th day of May, 1965.

My Commission Expires January 8, 1968

*Lois J. McCoy*  
Lois J. McCoy, Notary Public