

STATE OF KANSAS
STATE CORPORATION COMMISSION
200 Colorado Derby Building
Wichita, Kansas 67202

WELL PLUGGING RECORD
K.A.R.-82-3-117

API NUMBER 15-101-21,522-0000

LEASE NAME WILKENS "CC"

TYPE OR PRINT
NOTICE: Fill out completely
and return to Cons. Div.
office within 30 days.

WELL NUMBER 1

660 Ft. from S Section Line

1900 Ft. from E Section Line

SEC. 33 TWP. 16SRGE.30 (X) or (W)

COUNTY Lane

Date Well Completed July 21, 1989

Plugging Commenced _____

Plugging Completed _____

LEASE OPERATOR Slawson Exploration Company, Inc.

ADDRESS 104 S. Broadway Wichita, Kansas 67202

PHONE#(316) 263-3201 OPERATORS LICENSE NO. 3988

Character of Well D&A

(Oil, Gas, D&A, SWD, Input, Water Supply Well)

The plugging proposal was approved on July 20, 1989 (date)

by Dick Kapp Dist. 1 Dodge City, Ks. (KCC District Agent's Name).

Is ACO-1 filed? by operator If not, is well log attached? _____

Producing Formation _____ Depth to Top _____ Bottom _____ T.D. 2327'

Show depth and thickness of all water, oil and gas formations.

OIL, GAS OR WATER RECORDS

CASING RECORD

| Formation | Content | From | To | Size | Put in | Pulled out |
|----------------|---------|----------|------------|---------------|------------|-------------|
| <u>surface</u> | | <u>0</u> | <u>290</u> | <u>8 5/8"</u> | <u>290</u> | <u>none</u> |
| | | | | | | |
| | | | | | | |
| | | | | | | |

RECEIVED
STATE CORPORATION COMMISSION
7-28-89
JUL 28 1989

Describe in detail the manner in which the well was plugged, indicating where the mud fluid was placed and the method or methods used in introducing it into the hole. If cement or other materials were used, state the character of same and depth placed, from _____ feet to _____ feet.

40 sx. @ 2287, 80 sx. @ 1250, 40 sx. @ 320', 10 sx. @ 40', 15 sx. in rat hole

(If additional description is necessary, use BACK of this form.)

Name of Plugging Contractor Allied Cementing License No. _____

Address Russell, Kansas

NAME OF PARTY RESPONSIBLE FOR PLUGGING FEES: Slawson Exploration Company, Inc.


STATE OF KANSAS COUNTY OF BARTON, ss.

L. D. Davis (Employee of Operator) or (Operator) of above-described well, being first duly sworn on oath, says: That I have knowledge of the facts, statements, and matters herein contained and the log of the above-described well as filed that the same are true and correct, so help me God.

(Signature) L. D. Davis

(Address) L. D. Davis
R.R. 1 Box 183 B Great Bend, KS
67530

SUBSCRIBED AND SWORN TO before me this 26th day of July, 19 89

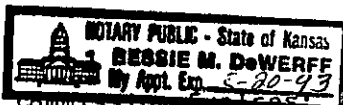

Bessie M. DeWerff
Notary Public
Bessie M. DeWerff

My Commission Expires 5-20-93

Must be approved by the K.C.C. five (5) days prior to commencing well

Expected Spud Date July 14 1989
month day year

Ap. C. SW. SE. Sec 33. Twp 16. S, Rg 30. X East West

OPERATOR: License # 3988
Name: SLAWSON EXPLORATION COMPANY, INC.
Address: 104 South Broadway
City/State/Zip: Wichita, Kansas 67202
Contact Person: Jim Remsburg
Phone: (316) 263-3201

660' feet from South line of Section
1900' feet from East line of Section
(Note: Locate well on Section Plat Below)

CONTRACTOR: License #: 6039
Name: L. D. DRILLING, INC.

County: Lane
Lease Name: Wilkens "GG" Well #: 1
Field Name: ~~Development~~ - UNKNOWN
Is this a Prorated Field? yes no
Target Formation(s): Mississippian
Nearest lease or unit boundary: 660'
Ground Surface Elevation: 2866' Gr. (Seis) not MSL
Domestic well within 330 feet: yes no
Municipal well within one mile: yes no
Depth to bottom of fresh water: 200' 180'
Depth to bottom of usable water: 1300'
Surface Pipe by Alternate: 1 2
Length of Surface Pipe Planned to be set: 290'
Length of Conductor pipe required: None
Projected Total Depth: 4600'
formation at Total Depth: Mississippian
Water Source for Drilling Operations: Irrig. Well
X well farm pond other

Well Drilled For: Well Class: Type Equipment:
X Oil Inj Infield X Mud Rotary
Gas Storage Pool Ext. Air Rotary
O&W Disposal X Wildcat Cable
Seismic: # of Holes

If O&W: old well information as follows:
Operator:
Well Name:
Comp. Date: Uld Total Depth


DWR Permit #: 26268
Will Cores Be Taken? yes no
If yes, proposed zone:

Directional, Deviated or Horizontal wellbore? yes no
If yes, total depth location:

Set 290' of 8 5/8" on 7/18/89 200' Alt. II Req.

PUSHER Greg Davidson
TD 2327' FORMATION
SURFACE PIPE 8 5/8" @ 290'
ANHYDRITE 2262-83' ELEVATION 2866'
STARTING TIME & DATE 4:30 AM 7-21-89
COMPLETION TIME & DATE 6:15 AM 7-21-89
1st PLUG @ 2285 FT. W/ 40 SX
2nd PLUG @ 1250 FT. W/ 80 SX
3rd PLUG @ 320 FT. W/ 40 SX
4th PLUG @ 40 FT. W/ 10 SX
RAT HOLE CIRCULATED W/ 15 SX
MOUSE HOLE CIRCULATED W/ SX
WATER WELL PLUGGED W/ SX
CEMENT COMPANY Allied
TECHNICIAN DG
8/10/40 690 HOP

RECEIVED
STATE CORPORATION COMMISSION
JUL 21 1989
Spud date: _____
Conservation Division
Wichita, Kansas

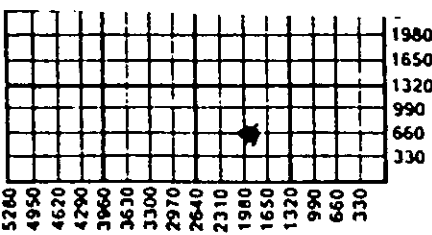

- REMEMBER TO:
- File Drill Pit Application (form CDP-1) with Intent to Drill;
 - File Completion Form ACO-1 within 120 days of spud date;
 - File acreage attribution plat according to field proration orders;
 - Notify appropriate district office 48 hours prior to workover or re-entry;
 - Submit plugging report (CP-4) after plugging is completed;
 - Obtain written approval before disposing or injecting salt water.

33 16 30w