


STATE OF KANSAS  
STATE CORPORATION COMMISSION

Give All Information Completely  
Make Required Affidavit  
Mail or Deliver Report to:  
Conservation Division  
State Corporation Commission  
212 No. Market  
Wichita, Kansas

15.165-30133-00-01

Form CP-4

WELL PLUGGING RECORD

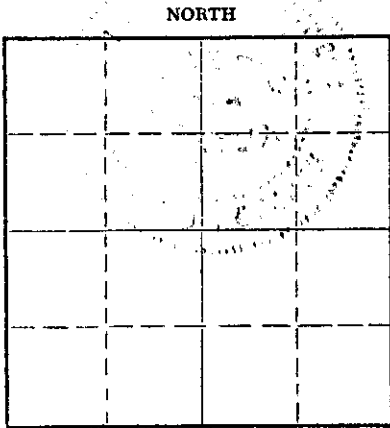

Locate well correctly on above  
Section Plat

Rush County. Sec. 16 Twp. 16 Rge. 18 (E) (W)  
Location as "NE/CNW&SW" or footage from lines  
Lease Owner R. C. (Dick) Davis  
Lease Name Legleiter #1 Well No. \_\_\_\_\_  
Office Address Wichita, Kansas 67202  
Character of Well (completed as Oil, Gas or Dry Hole) \_\_\_\_\_  
Date well completed \_\_\_\_\_ 19\_\_\_\_  
Application for plugging filed \_\_\_\_\_ 19\_\_\_\_  
Application for plugging approved \_\_\_\_\_ 19\_\_\_\_  
Plugging commenced 5/27/68 \_\_\_\_\_ 19\_\_\_\_  
Plugging completed 5/29/68 \_\_\_\_\_ 19\_\_\_\_  
Reason for abandonment of well or producing formation depleted.

If a producing well is abandoned, date of last production \_\_\_\_\_ 19\_\_\_\_  
Was permission obtained from the Conservation Division or its agents before plugging was commenced? yes

Name of Conservation Agent who supervised plugging of this well Massey  
Producing formation \_\_\_\_\_ Depth to top \_\_\_\_\_ Bottom \_\_\_\_\_ Total Depth of Well 3610 Feet  
Show depth and thickness of all water, oil and gas formations.

OIL, GAS OR WATER RECORDS

CASING RECORD

FORMATION	CONTENT	FROM	TO	SIZE	PUT IN	PULLED OUT
				8-5/8"	1122'	none
				5 1/2"	3609'	2928'

Describe in detail the manner in which the well was plugged, indicating where the mud fluid was placed and the method or methods used in introducing it into the hole. If cement or other plugs were used, state the character of same and depth placed, from \_\_\_\_\_ feet to \_\_\_\_\_ feet for each plug set.

Checked hole to 3610', ran sand from 3610' to 3580', dumped 5 sacks of cement. Shot pipe at 3119', 3025' and 2938', worked pipe loose and pulled 94 joints. Bailed fluid to 520' and set 20' rock bridge and dumped 7 yards of ready mix.

PLUGGING COMPLETE.


RECEIVED  
STATE CORPORATION COMMISSION  
JUN 4 1968  
CONSERVATION DIVISION  
Wichita, Kansas

(If additional description is necessary, use BACK of this sheet)  
Name of Plugging Contractor KNIGHT CASING PULLING CO., INC.  
Address CHASE, KANSAS

STATE OF KANSAS COUNTY OF RICE, ss.  
NOEL J. KNIGHT (employee of owner) or (owner or operator) of the above-described well, being duly sworn on oath, says: That I have knowledge of the facts, statements, and matters herein contained and the log of the above-described well and that the same are true and correct. So help me God.

(Signature) [Signature]  
CHASE, KANSAS

(Address)

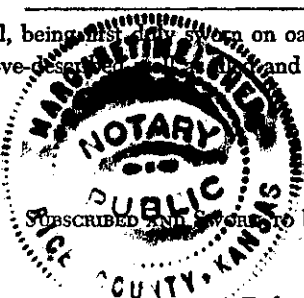

Subscribed and sworn to before me this 31st day of May, 1968  
My commission expires February 15, 1971

Margaret Melcher  
Notary Public.