


STATE OF KANSAS
STATE CORPORATION COMMISSION
200 Colorado Derby Bldg.
Wichita, Kansas 67202

WELL PLUGGING RECORD

Give All Information Completely
Make Required Affidavit

COUNTY Rush SEC. 16 TWP. 16S RGE. 18 XW
Location as in quarters or footage from lines:
C NE NE SW

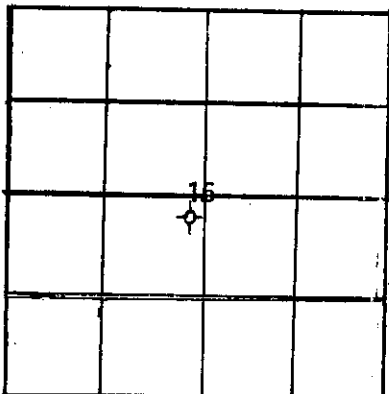

Lease Owner Frontier Oil Company
Lease Name Dolechek Well No. 1
Office Address 1720 KSB & T Bldg., Wichita, KS 67202
Character of Well (Completed as Oil, Gas or Dry Hole): D&A
Date Well Completed October 13, 1982
Application for plugging filed October 12, 1982
Plugging commenced October 13, 1982
Plugging completed October 13, 1982
Reason for abandonment of well or producing formation D&A

Locate Well
correctly on above
Section Platt.

Was permission obtained from the Conservation Division or it's
Agent's before plugging was commenced? yes

Name of Conservation Agent who supervised plugging of this well Bob Tarbutton

Producing formation _____ Depth to top _____ bottom _____ T.D. 3720'

Show depth and thickness of all water, oil and gas formations.

OIL, GAS OR WATER RECORDS

Casing Record

Formation	Content	From	To	Size	Put in	Pulled Out
				8-5/8"	1145.60'	-0-

Describe in detail the manner in which the well was plugged, indicating where the mud
fluid was placed and the method or methods used in introducing it into the hold. If cement
or other plugs were used, state the character of same and depth placed, from _____ feet
to _____ feet for each plug set.

Hole Plugged

1st @ 1178' w/70 sx
2nd @ 775' w/35 sx
@ 40' w/1/2 sx hulls, plug & 10 sx
10 sx in rathole.
Cmt. w/125 sx 50-50 poz 4% gel, 3% c.c.

RECEIVED
STATE CORPORATION COMMISSION

OCT 26 1982

CONSERVATION DIVISION
Wichita, Kansas

(Calculations by displacement)

(If additional description is necessary, use BACK of this sheet)

Name of Plugging Contractor Allied Cementing Company
Box 31, 332 W. Wichita, Russell, KS 67665

STATE OF KANSAS COUNTY OF SEDGWICK, ss.

George A. Angle (~~employee of owner~~ or ~~owner~~ operator) of the
above-described well, being first duly sworn on oath, says: That I have knowledge of the
facts, statements, and matters herein contained and the log of the above-described well as
filed and that the same are true and correct. So help me God.

(Signature) George A. Angle
1720 KST & T Bldg., Wichita, KS
(Address) 67202

SUBSCRIBED AND SWORN TO before me this 21st day of October, 19 82



Jean Stocks
Notary Public.

My Commission expires: _____