


STATE OF KANSAS  
STATE CORPORATION COMMISSION

WELL PLUGGING RECORD

Give All Information Completely  
Make Required Affidavit  
Mail or Deliver Report to  
Conservation Division  
State Corporation Comm.  
245 North Water  
Wichita, KS 67202

Rush County, Sec. 23 Twp. 16 Rge. 18 E/W  
Location as "NE/CNW $\frac{1}{4}$ SW $\frac{1}{4}$ " or footage from lines  
C NW/4  
Lease Owner Kansas Oil Corporation  
Lease Name Dechant Well No. One  
Office Address 400 North Woodlawn St 20, Wichita Ks. 67208  
Character of Well (Completed as Oil, Gas or Dry Hole)  
Dry Hole

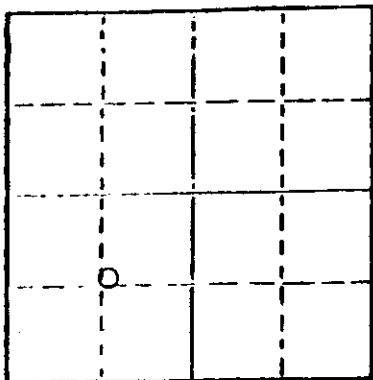

Locate well correctly on above  
Section Plot

Date Well completed 9-13-77 19  
Application for plugging filed 9-13-77 19  
Application for plugging approved 9-13-77 19  
Plugging commenced 9-8-77 19  
Plugging completed 9-13-77 19  
Reason for abandonment of well or producing formation  
Dry Hole

If a producing well is abandoned, date of last production 19

Was permission obtained from the Conservation Division or its agents before plugging was commenced? Yes

Name of Conservation Agent who supervised plugging of this well Leo F. Massey  
Producing formation None Depth to top Bottom Total Depth of Well 3372  
Show depth and thickness of all water, oil and gas formations.

OIL, GAS OR WATER RECORDS

CASING RECORD

FORMATION	CONTENT	FROM	TO	SIZE	PUT IN	PULLED OUT
Sand				8 5/8"	421 ft	None

Describe in detail the manner in which the well was plugged, indicating where the mud fluid was placed and the method or methods used in introducing it into the hold. If cement or other plugs were used, state the character of same and depth placed, from feet to feet for each plug set.

Plug 500' W/50 sx  
Plug 240' W/25 SX  
Plug 40' W/10 SX  
Rat Hole W/2 sx  
50/50 PAZ W 2% gel

RECEIVED  
SEP 19 1977  
9-19-77

(If additional description is necessary, use BACK of this sheet)

Name of Plugging Contractor Service Company  
Great Bend, Kansas


STATE OF Kansas COUNTY OF Sedgwick, ss.  
Paul A. Seymour, Jr. (employee of owner) or (owner or operator)  
of the above-described well, being first duly sworn on oath, says: That I have knowledge of the facts, statements, and matters herein contained and the log of the above-described well as filed and that the same are true and correct. So help me God.

(Signature) Paul A. Seymour, Jr.  
400 No. Woodlawn St. 29 Wichita, Ks.  
(Address) 67208

SUBSCRIBED AND SWORN TO before me this 16th day of September, 19 77

Ruth M. Bassett  
Ruth M. Bassett Notary Public.

My commission expires May 30, 1979

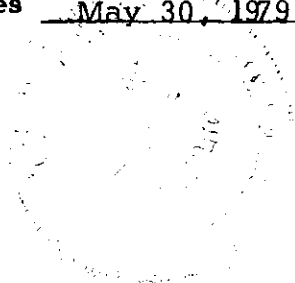

15-165-20645-0000

# BIG SPRINGS DRILLING, INC.

P.O. BOX 8287  
MUNGER STATION  
WICHITA, KANSAS 67208

SUITE 29 • 400 NORTH WOODLAWN • (316) 681-1732

September 16, 1977

## DRILLERS LOG

re: Kansas Oil Corporation  
No. 1 Dechant  
C NW/4 23 16-18W  
Rush County, Kansas

OPERATOR: Kansas Oil Corporation  
CONTRACTOR: Big Springs Drilling, Inc.  
COMMENCED: 9-8-77  
COMPLETED: 9-13-77

Surface pipe 8 5/8" 421' W/250 sx  
2% gel, 3%

0	425	Sand and shale
425	850	Lime
850	1151	Shale and Red Bed
1151	1210	Lime and Shale
1210	1998	Shale
1998	3000	Lime and Shale
3000	3061	Lime
3061	3372	Lime and Shale
3372		RTD

RECEIVED  
STATE COMMISSION  
SEP 16 1977  
CONSERVATION DIVISION  
Wichita, Kansas

We certify that the above and foregoing is a true and correct copy of the log on the #1 Dechant located in Rush County, Kansas

BIG SPRINGS DRILLING, INC.

  
Paul A. Seymour, Jr.

Subscribed and sworn to before me this 16th day of September, 1977.

  
Ruth M. Bassett

My Commission expires:  
May 30, 1979