

This form shall be filed in duplicate with the Kansas Corporation Commission, 200 Colorado Derby Building, Wichita, Kansas 67202, within ten days after the completion of the well, regardless of how the well was completed.

Attach separate letter of request if the information is to be held confidential. If confidential, only file one copy. Information on side one will be of public record and side two will then be held confidential.

Circle one: Oil, Gas, Dry, SWD, OWWO, Injection. Type and complete ALL sections.

Applications must be filed for dual completion, commingling, SWD and injection, T.A.

Attach wireline logs (i.e. electrical log, sonic log, gamma ray neutron log, etc.).

KCC # (316) 263-3238. (Rules 82-2-105 & 82-2-125)

OPERATOR Oil Capital Corporation

API NO. 15-101-20,569-0000

ADDRESS 411 Farmers & Bankers Bldg.

COUNTY Lane

Wichita, Kans. 67202

FIELD Dickey, C.

\*\*CONTACT PERSON Neil H. Sikes

PROD. FORMATION Cher., Ft. Scott

PHONE 316 862-1146

LEASE Dickey

PURCHASER

WELL NO. # 1

ADDRESS

WELL LOCATION SW SE NE

DRILLING Abercrombie Drlg. Co.

990 Ft. from East Line and

CONTRACTOR

1650 Ft. from North Line of

ADDRESS 801 Union Center Bldg.

the NE SEC. 25 TWP. 16S RGE. 30W


Wichita, Kans. 67202

WELL FLAT

PLUGGING

CONTRACTOR

ADDRESS

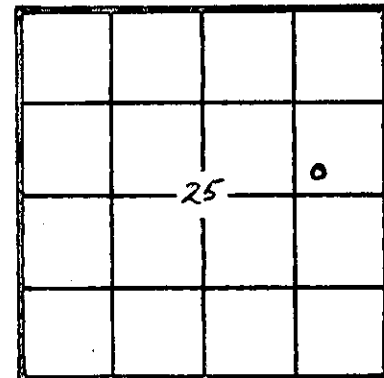

KCC  
KCS  
(Office Use)

TOTAL DEPTH 4570' PBT

SPUD DATE 10-5-81 DATE COMPLETED 10-15-81

ELEV: GR 2835 DF KB 2840

DRILLED WITH (CABLE) (ROTARY) (AIR) TOOLS

Rotary  
Amount of surface pipe set and cemented 282' Y.F. DV Tool Used? No

AFFIDAVIT

STATE OF Kansas, COUNTY OF Sedgwick SS, I,

Neil H. Sikes OF LAWFUL AGE, BEING FIRST DULY SWORN UPON HIS OATH,

DEPOSES THAT HE IS President (PRES) (OF) Oil Capital Corporation

OPERATOR OF THE Dickey LEASE, AND IS DULY AUTHORIZED TO MAKE

THIS AFFIDAVIT FOR AND ON THE BEHALF OF SAID OPERATOR, THAT WELL NO. 1 ON

SAID LEASE HAS BEEN COMPLETED AS OF THE 15 DAY OF Oct., 1981, AND THAT

ALL INFORMATION ENTERED HEREIN IS TRUE AND CORRECT.

FURTHER AFFIANT SAITH NOT.

FEB - 5 1982

CONSERVATION DIVISION

Wichita, Kansas

SUBSCRIBED AND SWORN BEFORE ME THIS 5th DAY OF FEBRUARY, 1982.

MY COMMISSION EXPIRES: 1-27-86

(S) Neil H. Sikes

Eleanor B. Williams


NOTARY PUBLIC STATE OF KANSAS

2-8-82

FEB 8 1982


Wichita, Kansas

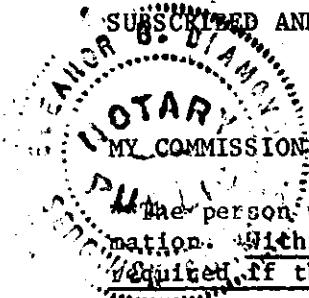



CONTRACTORS WELL LOG

OPERATOR: Oil Capital Corporation  
 CONTRACTOR: Abercrombie Drilling, Inc.  
 WELL NAME: DICKEY #1  
 LOCATION: SW SE NE, Sec. 25-16S-30W,  
 Lane County, Kansas  
 SPUD DATE: 10/05/81  
 COMPLETION DATE: 10/15/81

0	2242	Sand & Shale
2242	2272	Anhydrite
2272	2520	Sand & Shale
2520	3815	Shale
3815	4005	Lime & Shale
4005	4202	Shale & Lime
4202	4223	Lime & Shale
4223	4374	Shale & Lime
4374	4380	Lime & Shale
4380	4414	Shale & Lime
4414	4480	Lime & Shale
4480	4520	Shale & Lime
4520	4558	Lime & Shale
4558	4570	Shale & Lime
	4570	Rotary Total Depth

Spud hole @ 4:45 p.m., 10/05/81. Drilled 285' of a 12½" hole. Ran 7 joints of 8 5/8" 20# casing set @ 282' K.B. and Cemented with 210 sx. Common 2% gel, 3% c.c. Pumped plug to 267' K.B. Cement did circulate. Plug was down @ 9:45 p.m., 10/05/81.

4570' RTD. Ran 111 joints 4½" 9½# casing set @ 4572' KB and cemented with 100 sx. 50-50 nos-mix, 2% gel, 18% Salt, .75% CFR 2. Pumped plug to 4537' KB. Plug was down @ 7:45 p.m., 10/15/81.

SAMPLE TOPS:

Anhydrite 2242'  
 B/Anhydrite 2272'

STATE OF KANSAS )  
 ) SS  
 COUNTY OF SEDGWICK )

Jack L. Partridge, Vice President of Abercrombie Drilling, Inc., does hereby state that the above and foregoing is a true and correct copy of the log of the DICKEY #1, SW SE NE, Sec. 25-16S-30W, Lane County, Kansas.

ABERCROMBIE DRILLING, INC.

BY: Jack L. Partridge  
 Jack L. Partridge, Vice President

Subscribed and sworn to before me, a Notary Public, in and for the aforesaid county and state as of this 20th day of October 1981.

RECEIVED  
 STATE CORPORATION COMMISSION

FEB - 8 1982

CONSERVATION DIVISION  
 Wichita, Kansas

RECEIVED  
 STATE CORPORATION COMMISSION

my commission expires 7-13-85

Elizabeth G. Terry  
 Elizabeth G. Terry  
 NOTARY PUBLIC  
 ELIZABETH G. TERRY  
 NOTARY PUBLIC  
 STATE OF KANSAS

FEB - 5 1982

CONSERVATION DIVISION  
 Wichita, Kansas