


STATE OF KANSAS
STATE CORPORATION COMMISSION
200 Colorado Derby Bldg.
Wichita, Kansas 67202

Form CP-4
Rev. 12-15-80

WELL PLUGGING RECORD

Give All Information Completely
Make Required Affidavit

COUNTY Rush SEC. 6 TWP. 16 RGE. 19 E/W
Location as in quarters or footage from lines:
SW SW SE 310' from S line 2310' from East line

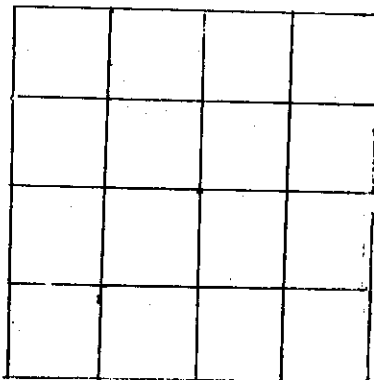

Locate Well
correctly on above
Section Platt.

Lease Owner Viking Resources
Lease Name Rogers Well No. 1
Office Address 217 East William Wichita, Kansas 67202-4005
Character of Well (Completed as Oil, Gas or Dry Hole): Dry Hole
Date Well Completed 3/27/83
Application for plugging filed 4/12/83
Plugging commenced 3/27/83 4:15 p m
Plugging completed 3/27/83 3: am
Reason for abandonment of well or producing formation No
commercial quantity of oil or gas encountered.
Was permission obtained from the Conservation Division or it's
Agent's before plugging was commenced? yes

Name of Conservation Agent who supervised plugging of this well Steve Durant
Producing formation _____ Depth to top _____ bottom _____ T.D. 3735'
Show depth and thickness of all water, oil and gas formations.

OIL, GAS OR WATER RECORDS

Casing Record

Formation	Content	From	To	Size	Put in	Pulled Out
Surface Hole	Sand & Shale	Surf. 0	288	8 5/8	288.28	None

Describe in detail the manner in which the well was plugged, indicating where the mud fluid was placed and the method or methods used in introducing it into the hold. If cement or other plugs were used, state the character of same and depth placed, from _____ feet to _____ feet for each plug set.

Fluid 1025' plug w/ 90 sx
Fluid 330' plug w/30 xx
Fluid 40' solid bridge w 10 sx.
Rat hole w/ 10 sx

(If additional description is necessary, use BACK of this sheet)
Name of Plugging Contractor _____

D N B DRILLING, INC.
615 R. H. Garvey Building
Wichita, Kansas 67202

STATE OF Kansas COUNTY OF Sedgwick, ss.
James L. Donelson (employee of owner) or (owner or operator) of the
above-described well, being first duly sworn on oath, says: That I have knowledge of the
facts, statements, and matters herein contained and the log of the above-described well as
filed and that the same are true and correct. So help me God.

(Signature) James L. Donelson
P. O. Box 8292 C Wichita, Kansas 67208
(Address)




SUBSCRIBED AND SWORN TO before me this 12 day of April, 19 83

My Commission expires: November 5, 1984

Fred G. Arasmith
Notary Public.
STATE CORPORATION COMMISSION

APR 18 1983

CONSERVATION DIVISION
Wichita Kansas

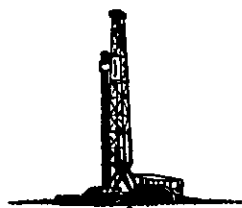

D N B Drilling, Inc.

ROTARY CONTRACTOR DRILLING DEALS

J. L. DONELSON, PRES.
(316) 687-5471

535 NORTH OLIVER P.O. BOX 8292C

WICHITA, KANSAS 67208

DRILLER'S LOG

Viking Resources
Rogers # 1
SW SW SE
Sec. 6-16S-19W
Rush Co., Kansas

Commenced 3/19/83
Completed 3/27/83

Surface Casing: 288.28' of 8 5/8"
cmntd. w/200 sx common 60/40 pods
3 % Gel 3 % CC

FORMATION

Surface hole
Sand & Shale
Anhydrite
Shale
Shale and Shells
Shale
Lime
Shale & Lime
Lime

DEPTH

0 - 288
288 - 1291
1291 - 1328
1328 - 1625
1625 - 2020
2020 - 2635
2635 - 2785
2785 - 3305
3305 - 3735 RTD

I do hereby certify that the foregoing statements are true and correct to the best of my knowledge and belief.

D N B Drilling, Inc.


James L. Donelson RECEIVED
STATE CORPORATION COMMISSION
James L. Donelson

APR 18 1983

State of Kansas: ss

CONSERVATION DIVISION
Wichita, Kansas

Subscribed and sworn to before me this 11th day of April, 1983.

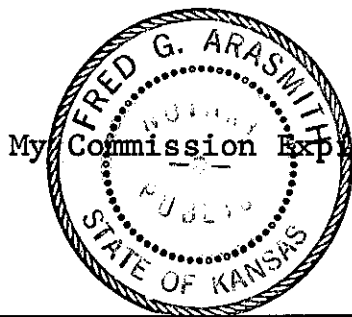

Fred G. Arasmith
Fred G. Arasmith, Notary Public

My Commission Expires November 5, 1984.