


WELL PLUGGING RECORD

Give All Information Completely  
Make Required Affidavit  
Mail or Deliver Report to:  
Conservation Division  
State Corporation Commission  
212 North Market, Insurance Bldg.  
Wichita, Kansas

NORTH

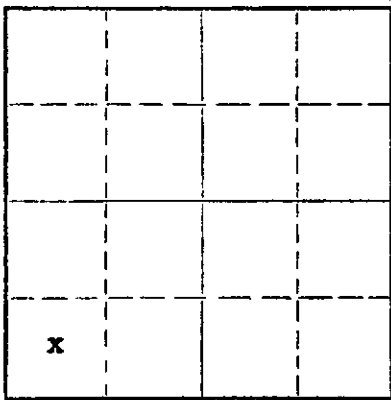

Locate well correctly on above  
Section Plat

Rush County. Sec. 10 Twp. 16 Rge. 19 (E) W (W)  
Location as "NE/CNW/SW" or footage from lines C SW SW  
Lease Owner R. A. Comeau  
Lease Name Murry Well No. 1  
Office Address Box 423, Plainville, Kansas  
Character of Well (completed as Oil, Gas or Dry Hole) Dry Hole  
Date well completed April 29 19 65  
Application for plugging filed April 29 19 65  
Application for plugging approved April 29 19 65  
Plugging commenced 1:00 A.M. April 29, 19 65  
Plugging completed 2:35 A.M. April 29 19 65  
Reason for abandonment of well or producing formation Dry Hole

If a producing well is abandoned, date of last production 19  
Was permission obtained from the Conservation Division or its agents before plugging was commenced? Yes

Name of Conservation Agent who supervised plugging of this well Eldon Petty  
Producing formation \_\_\_\_\_ Depth to top \_\_\_\_\_ Bottom \_\_\_\_\_ Total Depth of Well 3729 Feet  
Show depth and thickness of all water, oil and gas formations.

OIL, GAS OR WATER RECORDS

CASING RECORD

FORMATION	CONTENT	FROM	TO	SIZE	PUT IN	PULLED OUT
		0	285	7"	285	0

Describe in detail the manner in which the well was plugged, indicating where the mud fluid was placed and the method or methods used in introducing it into the hole. If cement or other plugs were used, state the character of same and depth placed, from \_\_\_\_\_ feet to \_\_\_\_\_ feet for each plug set.

Plugged with 20 sx cement @ 540 ft.  
Plugged with 20 sx cement @ 240 ft.  
Plugged with 10 sx cement @ 40 ft. to surface.  
Plugged by Sun Cementing Co. Pump truck.

RECEIVED  
STATE CORPORATION COMMISSION

MAY 17 1965

CONSERVATION DIVISION  
Wichita, Kansas

(If additional description is necessary, use BACK of this sheet)  
Name of Plugging Contractor Chemical & Technical Services, Inc.,  
Address P. O. Box D, Hill City, Kansas

STATE OF Kansas, COUNTY OF Graham, ss.  
D. P. McCarthy (employee of owner or operator) of the above-described well, being first duly sworn on oath, says: That I have knowledge of the facts, statements, and matters herein contained and the log of the above-described well as filed and that the same are true and correct. So help me God.

(Signature) D. P. McCarthy  
P. O. Box D, Hill City, Kansas  
(Address)

SUBSCRIBED AND SWORN TO before me this 11th day of May, 1965

My Commission Expires January 20, 1968

My commission expires \_\_\_\_\_

Loan Dallen  
Notary Public.

15.1165-30013-0000

CONTRACTOR'S WELL LOG

OWNER:	R. A. COMEAU
CONTRACTOR:	CHEMICAL & TECHNICAL SERVICES, INC.
WELL:	MURRY # 1
LOCATION:	C SW SW SEC. 10-16S-19W Rush County, Kansas
COMMENCED:	APRIL 21, 1965
COMPLETED:	APRIL 29, 1965

0	130	Clay, post rock & shale
130	286	Shale
286	650	Clay & Sand
650	875	Red Shale & Sand
875	1295	Sand, Shale & Redbed
1295	1336	Anhydrite
1336	1360	Redbed
1360	2090	Redbed & Shale
2090	2290	Redbed, Salt & Lime
2290	2583	Lime
2583	3391	Lime & Shale
3391	3729	Lime
3729		Rotary Total Depth

RECEIVED  
STATE CORPORATION COMMISSION

MAY 13 1965

CONSERVATION DIVISION  
Wichita, Kansas

Set 7" Surface Casing @ 285 ft. with 120 sx cement

DRY & ABANDONED

We hereby certify that the above is a correct and accurate log of the above mentioned well, as shown on the daily drilling reports.

CHEMICAL & TECHNICAL SERVICES, INC.

BY:

*R. F. McCarthy*  
Asst. Treasurer

Subscribed and sworn to before me this 11th day of May, 1965.

My Commission Expires January 20, 1968

*Con. Dwyer*  
Notary Public