


WELL PLUGGING RECORD

Give All Information Completely
Make Required Affidavit
Mail or Deliver Report to
Conservation Division
State Corporation Comm.
245 North Water
Wichita, KS 67202

Rush County, Sec. 7 Twp. 16S Rge. 18W E/
Location as "NE/CNW/SW" or footage from lines
SW NE NW

Lease Owner DaMar Oil Explorations
Lease Name Gottschalk Well No. #1
Office Address P. O. Box 70, Hays, Kansas 67601
Character of Well (Completed as Oil, Gas or Dry Hole)
Dry Hole

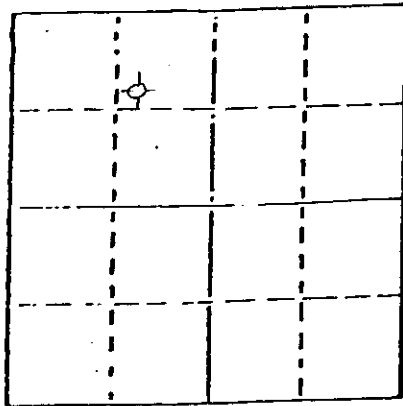

Locate well correctly on above
Section Plot

Date Well completed July 14, 1983 19
Application for plugging filed July 14, 1983 19
Application for plugging approved July 14, 1983 19
Plugging commenced July 14, 1983 19
Plugging completed July 14, 1983 19
Reason for abandonment of well or producing formation
Dry Hole

If a producing well is abandoned, date of last production
N/A 19

Was permission obtained from the Conservation Division or
its agents before plugging was commenced? Yes

Name of Conservation Agent who supervised plugging of this well Steve Durrant
Producing formation _____ Depth to top _____ Bottom _____ Total Depth of Well 3715'
Show depth and thickness of all water, oil and gas formations.

OIL, GAS OR WATER RECORDS

CASING RECORD

FORMATION	CONTENT	FROM	TO	SIZE	PUT IN.	PULLED OUT
Sand				8 5/8"	1250'	none

Describe in detail the manner in which the well was plugged, indicating where the mud fluid
was placed and the method or methods used in introducing it into the hold. If cement or other
plugs were used, state the character of same and depth placed, from _____ feet to
_____ feet for each plug set.

RECEIVED
STATE CORPORATION COMMISSION

JUL 29 1983

CONSERVATION DIVISION
Wichita, Kansas

1290' 50 SX
600' 40 SX
40' 10 SX
RH 15 SX

60 - 40 POZ 2% gel 3% ccl 11:00 PM

(If additional description is necessary, use BACK of this sheet)


Name of Plugging Contractor Allied Cementing Co., Inc.

STATE OF KANSAS COUNTY OF ELLIS, ss.
DANIEL F. SCHIPPERS, Operator (employee of owner) or (owner or operator)

the above-described well, being first duly sworn on oath, says: That I have knowledge of
the facts, statements, and matters herein contained and the log of the above-described well
filed and that the same are true and correct. So help me God.

(Signature) Daniel F. Schippers
217 E. 32nd, P.O. Box 70, Hays, KS 67601
(Address)

SUBSCRIBED AND SWORN TO before me this 28th day of July, 1983

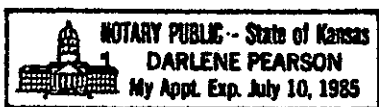

Darlene Pearson
Notary Public.

commission expires _____