

EFFECTIVE DATE: 12-02-91
DISTRICT # 4
SEAT X Yes... No

State of Kansas
NOTICE OF INTENTION TO DRILL

FORM MUST BE TYPED
FORM MUST BE SIGNED
ALL BLANKS MUST BE FILLED

Must be approved by the K.C.C. five (5) days prior to commencing well

Expected Spud Date 12-2-91
month day year

Spot
.SW.-NE...NE.. Sec .14. Twp .11S S. Rg 19.. X East West

OPERATOR: License # 30606
Name: Murfin Drilling Company, Inc.
Address: 250 North Water, Suite 300
City/State/Zip: Wichita, Ks. 67202
Contact Person: Scott Robinson
Phone: 316-267-3241

870 feet from South / North line of Section
1050 feet from East / West line of Section
IS SECTION X REGULAR IRREGULAR?

(NOTE: Locate well on the Section Plat on Reverse Side)
County: Ellis
Lease Name: METZ "B" Well #: 1-14
Field Name: unknown
Is this a Prorated/Spaced Field? ... yes X.. no
Target Formation(s): LKG/Arbuckle
Nearest lease or unit boundary: 330' 870'
Ground Surface Elevation: 1961' feet MSL
Water well within one-quarter mile: ... yes X.. no
Public water supply well within one mile: ... yes X.. no
Depth to bottom of fresh water: 600' 100'
Depth to bottom of usable water: 1000' 740'
Surface Pipe by Alternate: X 1 ... 2
Length of Surface Pipe Planned to be set: 1300'
Length of Conductor pipe required: N/A
Projected Total Depth: 3650'
Formation at Total Depth: Arbuckle
Water Source for Drilling Operations:
... well ... farm pond X other
DWR Permit #: _____
Will Cores Be Taken?: ... yes X.. no
If yes, proposed zone: _____

CONTRACTOR: License #: 30606
Name: Murfin Drilling Company, Inc.

Well Drilled For: Well Class: Type Equipment:
X Oil ... Enh Rec ... Infield X Mud Rotary
... Gas ... Storage X Pool Ext. ... Air Rotary
... OWWO ... Disposal ... Wildcat ... Cable
... Seismic; ... # of Holes ... Other
... Other

If OWWO: old well information as follows:
Operator: _____
Well Name: _____
Comp. Date: _____ Old Total Depth _____

Directional, Deviated or Horizontal wellbore? ... yes X.. no
If yes, true vertical depth: _____
Bottom Hole Location: _____

AFFIDAVIT

The undersigned hereby affirms that the drilling, completion and eventual plugging of this well will comply with K.S.A. 55-101, et. seq.
It is agreed that the following minimum requirements will be met:

1. Notify the appropriate district office prior to spudding of well;
2. A copy of the approved notice of intent to drill shall be posted on each drilling rig;
3. The minimum amount of surface pipe as specified below shall be set by circulating cement to the top; in all cases surface pipe shall be set through all unconsolidated materials plus a minimum of 20 feet into the underlying formation;
4. If the well is dry hole, an agreement between the operator and the district office on plug length and placement is necessary prior to plugging;
5. The appropriate district office will be notified before well is either plugged or production casing is cemented in;
6. IF AN ALTERNATE II COMPLETION, PRODUCTION PIPE SHALL BE CEMENTED FROM BELOW ANY USABLE WATER TO SURFACE WITHIN 120 DAYS OF SPUD DATE. IN ALL CASES, NOTIFY DISTRICT OFFICE PRIOR TO ANY CEMENTING.

I hereby certify that the statements made herein are true and to the best of my knowledge and belief.
Date: 11-27-91 Signature of Operator or Agent: C. Scott Robinson Title: Geo. Mgr

RECEIVED
KANSAS CORPORATION COMMISSION
NOV 27 1991

FOR KCC USE:
API # 15- 051-24,773-0000
Conductor pipe required NONE feet
Minimum surface pipe required 740' feet per Alt (1)X
Approved by: DPW 11-27-91
This authorization expires: 5-27-92
(This authorization void if drilling not started within 6 months of effective date.)
Spud date: _____ Agent: _____

*FAX to DIST
11-22-91 4:55 PM
OPER will call
prior to spud -
PITS MUST be MSP
Per JR
DPW
11-27-91*

CONSERVATION DIVISION
WICHITA, KS

- REMEMBER TO:
- File Drill Pit Application (form CDP-1) with Intent to Drill;
 - File Completion Form ACO-1 within 120 days of spud date;
 - File acreage attribution plat according to field proration orders;
 - Notify appropriate district office 48 hours prior to workover or re-entry;
 - Submit plugging report (CP-4) after plugging is completed;
 - Obtain written approval before disposing or injecting salt water.

Mail Conservation Division, 200 Colorado Derby Building, 202 W. First St., Wichita, Kansas 67202-1286.



MBT

IN ALL CASES PLOT THE INTENDED WELL ON THE PLAT BELOW

PLAT OF ACREAGE ATTRIBUTABLE TO A WELL IN A PRORATED OR SPACED FIELD

If the intended well is in a prorated or spaced field, please fully complete this side of the form. If the intended well is in a prorated or spaced field complete the plat below showing that the well will be properly located in relationship to other wells producing from the common source of supply. Please show all the wells within 1 mile of the boundaries of the proposed acreage attribution unit for gas wells and within 1/2 mile of the boundaries of the proposed acreage attribution unit for oil wells.

API NO. 15- _____
 OPERATOR Murfin Drilling Company, Inc.
 LEASE METZ "B"
 WELL NUMBER 1-14
 FIELD unknown

LOCATION OF WELL: COUNTY Ellis
870 feet from south/north line of section
1050 feet from east/west line of section
 SECTION 14 TWP 11S RG 19W



NUMBER OF ACRES ATTRIBUTABLE TO WELL 40
 QTR/QTR/QTR OF ACREAGE SW - NE - NE

IS SECTION X REGULAR or IRREGULAR
IF SECTION IS IRREGULAR, LOCATE WELL FROM NEAREST CORNER BOUNDARY.

Section corner used: NE NW SE SW

PLAT

(Show location of the well and shade attributable acreage for prorated or spaced wells.)
 (Show footage to the nearest lease or unit boundary line.)

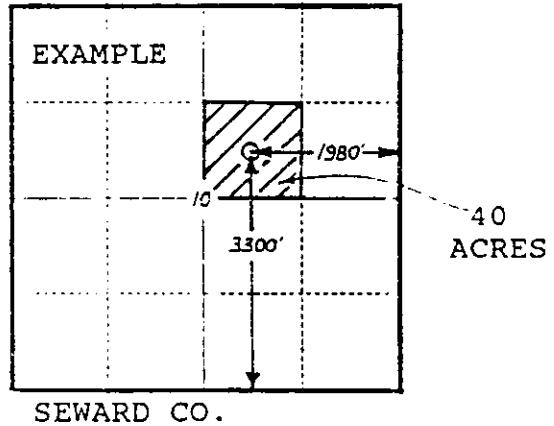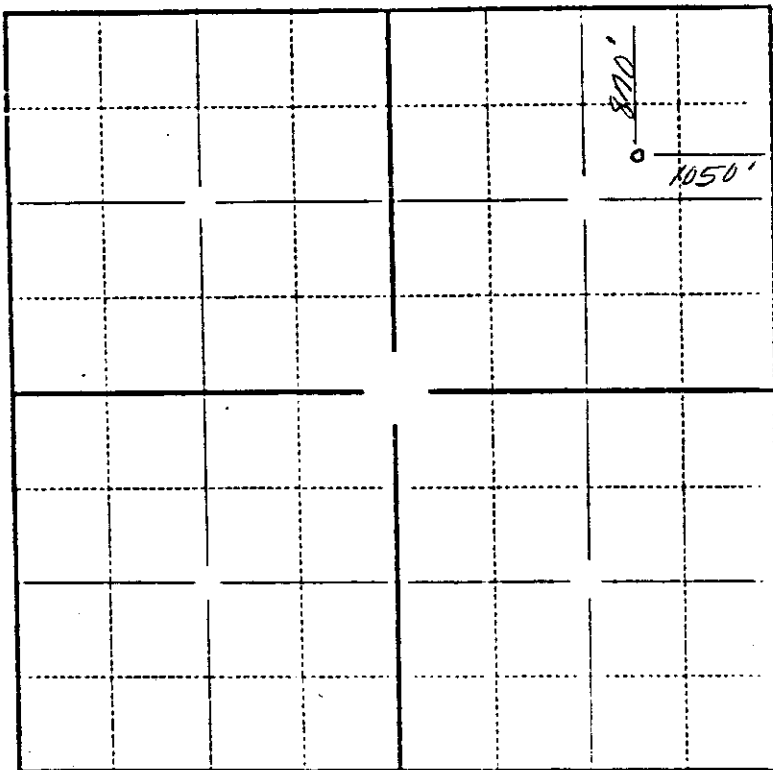

In plotting the proposed location of the well, you must show:

- 1) The manner in which you are using the depicted plat by identifying section lines, i.e. 1 section, 1 section with 8 surrounding sections, 4 sections, etc.;
- 2) the distance of the proposed drilling location from the section's south/north and east/west lines; and
- 3) the distance to the nearest lease or unit boundary line.

