

CARD MUST BE TYPED

State of Kansas
NOTICE OF INTENTION TO DRILL

CARD MUST BE SIGNED

(see rules on reverse side)

Starting Date: 2 7 85
month day year

API Number 15- 165-21,286-0000

OPERATOR: License # 5313
Name F & M OIL CO., INC.
Address 422 Union Center
City/State/Zip Wichita, Kansas 67202
Contact Person R. D. Messinger
Phone (316)262-2636

SE SE SW See 30 Twp 16 S, Rge 20W
(location) East West

CONTRACTOR: License # 5103
Name Union Drilling Co., Inc.
City/State Wichita, Kansas 67202

330 Ft North from Southeast Corner of Section
2970 Ft West from Southeast Corner of Section
(Note: Locate well on Section Plat on reverse side)

Well Drilled For: Well Class: Type Equipment:
 Oil Swd Infield Mud Rotary
 Gas Inj Pool Ext. Air Rotary
 OWWO Expl Wildcat Cable

Nearest lease or unit boundary line 330 feet.
County Rush
Lease Name Peer "B" Well# 1
Domestic well within 330 feet: yes no
Municipal well within one mile: yes no

If OWWO: old well info as follows:
Operator N/A
Well Name _____
Comp Date _____ Old Total Depth _____
Projected Total Depth 4100 feet
Projected Formation at TD Arbuckle
Expected Producing Formations Cherokee

Depth to Bottom of fresh water 100 feet
Lowest usable water formation Dakota
Depth to Bottom of usable water 600 feet
Surface pipe by Alternate: 1 2
Surface pipe to be set 640 feet
Conductor pipe if any required _____ feet
Ground surface elevation _____ feet MSL
This Authorization Expires 7-29-85
Approved By 1-29-85

I certify that we will comply with K.S.A. 55-101, et seq., plus eventually plugging hole to M.C.C. specifications.


Date 1-25-85 Signature of Operator or Agent

[Signature] Vice-President
MHC/KOHE 1-29-85

Must be filed with the K.C.C. five (5) days prior to commencing well
This card void if drilling not started within six (6) months of date received by K.C.C.

Important procedures to follow :

**A Regular Section of Land
1 Mile = 5,280 Ft.**

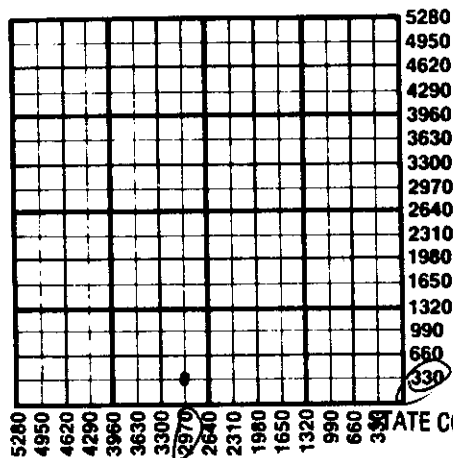

1. Notify District office before setting surface casing.
2. Set surface casing by circulating cement to the top.
3. File completion forms ACO-1 with K.C.C. within 90 days of well completion, following instructions on ACO-1, side 1, and including copies of wireline logs.
4. Notify District office 48 hours prior to old well workover or re-entry.
5. Prior to plugging, prepare a plugging plan, then obtain agreement from the appropriate district office for an approved plugging plan.
6. Submit plugging report (CP-4) to K.C.C. after plugging is completed.
7. Obtain an approved injection docket number before disposing of salt water.
8. Notify K.C.C. within 10 days when injection commences or terminates.
9. If an alternate 2 completion, cement in the production pipe from below any usable water to surface within 120 days of spud date.

RECEIVED
STATE CORPORATION COMMISSION

State Corporation Commission of Kansas
Conservation Division
200 Colorado Derby Building
Wichita, Kansas 67202
(316) 263-3238

JAN 29 1985

CONSERVATION DIVISION
Wichita, Kansas