

NOTICE OF INTENTION TO DRILL

(see rules on reverse side)

Starting Date 9 8 86
 month day year

OPERATOR: License # 5131
 Name .. Thunderbird Drilling, Inc.
 Address .. P.O. Box 780407
 City/State/Zip .. Wichita, Kansas 67278
 Contact Person..... Burke Krueger
 Phone (316) 685-1441

CONTRACTOR: License # ~~5131~~ 5302
 Name .. Red Tiger Drilling Co., Inc.
 City/State .. Wichita, Ks.

Well Drilled For:	Well Class:	Type Equipment:
<input checked="" type="checkbox"/> Oil <input type="checkbox"/> SWD <input type="checkbox"/> Infield <input checked="" type="checkbox"/> Mud Rotary		
<input type="checkbox"/> Gas <input type="checkbox"/> Inj <input type="checkbox"/> Pool Ext. <input type="checkbox"/> Air Rotary		
<input type="checkbox"/> OWWO <input type="checkbox"/> Expl <input checked="" type="checkbox"/> Wildcat <input type="checkbox"/> Cable		

If OWWO: old well info as follows:

Operator
 Well Name
 Comp Date Old Total Depth.....

I certify that well will comply with K.S.A. 55-101, et seq., plus eventually plugging hole to KCC specifications.

☒ Cementing will be done immediately upon setting production casing.

Date 9/2/86 Signature of Operator or Agent *Howard Dyson* Title Land Mgr.

For KCC Use:

Conductor Pipe Required feet; Minimum Surface Pipe Required 200 feet per Alt. # 2

This Authorization Expires 3-3-87 Approved By 9-3-86 *[Signature]*

API Number 15— 165-21,362-0000

SE. SE. NE. Sec.. 20. Twp.. 16. S, Rg.. 20. ☒ East
 2970 Ft. from South Line of Section
 330 Ft. from East Line of Section

(Note: Locate well on Section Plat on reverse side)

Nearest lease or unit boundary line 330 feet
 County..... Rush
 Lease Name... NORTH "A" Well # ... 1
 Ground surface elevation 2155 feet MSL
 Domestic well within 330 feet: yes ☒ no
 Municipal well within one mile: yes ☒ no
 Surface pipe by Alternate: 1 ☒ 2 ☒
 Depth to bottom of fresh water..... 200
 Depth to bottom of usable water ~~525~~ 4850
 Surface pipe planned to be set 280
 Projected Total Depth 4100 feet
 Formation..... Mississippian


204/KCC

Must be filed with the K.C.C. five (5) days prior to commencing well
This card void if drilling not started within six (6) months of date received by K.C.C.

Important procedures to follow:

1. Notify District office before setting surface casing.
2. Set surface casing by circulating cement to the top.
3. File completion forms ACO-1 with K.C.C. within 90 days of well completion, following instructions on ACO-1, side 1, and including copies of wireline logs.
4. Notify District office 48 hours prior to old well workover or re-entry.
5. Prior to filing Intent, prepare a proposed plugging plan in case well is D & A, then obtain approval of plan when calling district office prior to setting surface pipe.
6. Submit plugging report (CP-4) to K.C.C. after plugging is completed.
7. Obtain an approved injection docket number before disposing of salt water.
8. Notify K.C.C. within 10 days when injection commences or terminates.
9. If an alternate 2 completion, cement in the production pipe from below any usable water to surface within 120 days of spud date.

A Regular Section of Land
1 Mile = 5,280 Ft.

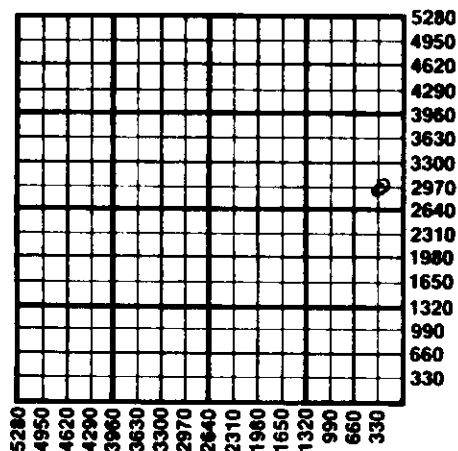

State Corporation Commission of Kansas
Conservation Division
200 Colorado Derby Building
Wichita, Kansas 67202
(316) 263-3238

SEP

3 1986