

FORM MUST BE TYPED
FORM C-1

State of Kansas

FORM MUST BE SIGNED
ALL BLANKS MUST BE FILLED

EFFECTIVE DATE: 2/28/90

NOTICE OF INTENTION TO DRILL

Must be approved by the K.C.C. five (5) days prior to commencing well

Expected Spud Date February 28, 1990
month day year

** 50'S of
NW SE NE Sec 18 Twp 18 S, Rg 26 East
** West
3580
..... feet from South line of Section
990
..... feet from East line of Section
(Note: Locate well on Section Plat Below)

OPERATOR: License # 30080
Name: HONEY OIL CO., INC.
Address: 401 East Douglas - Suite 505
City/State/Zip: Wichita, Kansas 67202
Contact Person: Stan Bell
Phone: 316/253-7300

County: Ness
Lease Name: Herl Well #: 1
Field Name: Wildcat
Is this a Prorated field? yes no
Target Formation(s): Mississippi
Nearest lease or unit boundary: 990
Ground Surface Elevation: 2627 feet MSL
Domestic well within 330 feet: yes no
Municipal well within one mile: yes no
Depth to bottom of fresh water: 105'
Depth to bottom of usable water: 895'
** Surface Pipe by Alternate: 1 2
** Length of Surface Pipe Planned to be set: 200'
Length of Conductor pipe required: N/A
Projected Total Depth: 4600'
Formation at Total Depth: Mississippi
Water Source for Drilling Operations:
..... well farm pond other
DWR Permit #:
Will Cores Be Taken?: yes no
If yes, proposed zone:

CONTRACTOR: License # 5929
Name: DUKE DRILLING CO., INC.

Well Drilled for: Well Class: Type Equipment:
..X Oil ... Inj ... Infield X Mud Rotary
... Gas ... Storage ... Pool Ext. ... Air Rotary
... OWD ... Disposal X Wildcat ... Cable
... Seismic; ... # of Holes

If OWD: old well information as follows:

Operator:
Well Name:
Comp. Date: Old Total Depth

Directional, Deviated or Horizontal wellbore? yes ...X no
If yes, total depth locations:

* WAS: NW SE NE /3630' FSL
WAS: Alt. 1 1120' Surf. Csg.

* WAS 2624 GL.

AFFIDAVIT


The undersigned hereby affirms that the drilling, completion and eventual plugging of this well will comply with K.S.A. 55-101, et. seq.

It is agreed that the following minimum requirements will be met:

- 1. The appropriate district office shall be notified before setting surface pipe;
- 2. The minimum amount of surface pipe as specified above shall be set by circulating cement to the top; in all cases surface pipe shall be set through all unconsolidated materials plus a minimum of 20 feet into the underlying formation;
- 3. If the well is dry, a plugging proposal shall be submitted to the district office. An agreement between the operator and the district office on plug length and placement is necessary prior to plugging;
- 4. The appropriate district office will be notified before well is either plugged or production casing is cemented in;
- 5. If an Alternate II completion, production pipe shall be cemented from below any usable water to surface within 120 days of spud date. In all cases, notify district office prior to any cementing.

I hereby certify that the statements made herein are true and to the best of my knowledge and belief.

Date: 2/23/90 Signature of Operator or Agent: Sally R. Byers Title: Agent

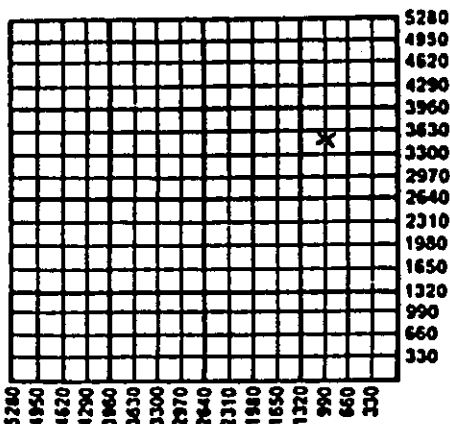

FEB 26 1990

Conservation Division
Wichita, Kansas

FOR KCC USE:
API # 15- 135-23,436-0000
Conductor pipe required NONE feet
Minimum surface pipe required 200 feet per Alt. ②
Approved by: ISGF 2/23/90, ISGF 2/27/90
EFFECTIVE DATE: 2/28/90
This authorization expires: 8/23/90
(This authorization void if drilling not started within 6 months of effective date.)
Spud date: _____ Agent: _____

18
18
26

REMEMBER TO:

- File Drill Pit Application (form CDP-1) with Intent to Drill;
- File Completion Form ACO-1 within 120 days of spud date;
- File acreage attribution plat according to field proration orders;
- Notify appropriate district office 48 hours prior to workover or re-entry;
- Submit plugging report (CP-4) after plugging is completed;
- Obtain written approval before disposing or injecting salt water.