

NOTICE OF INTENTION TO DRILL

(see rules on reverse side)

Expected Spud Date..... September 15, 1988
 month day year

API Number 15-~~35-23,286-0000~~ ✓

OPERATOR: License # 8541
 Name Petex, Inc.
 Address 1111 S. Glenstone, #1-104
 City/State/Zip Springfield, MO 65804
 Contact Person Larry Childress
 Phone (417) 862-2177

E 1/2 W 1/2 NE Sec. 17 Twp. 18 S, Rg. 24
 3960 Ft. from South Line of Section
 1650 Ft. from East Line of Section

(Note: Locate well on Section Plat on reverse side)

CONTRACTOR: License # 5104
 Name Blue Goose Drilling
 City/State Great Bend, KS

Nearest lease or unit boundary line 9.90 feet
 County Ness

Well Drilled For:	Well Class:	Type Equipment:
<input checked="" type="checkbox"/> Oil	<input type="checkbox"/> Storage	<input type="checkbox"/> Infield
<input type="checkbox"/> Gas	<input type="checkbox"/> Inj	<input type="checkbox"/> Pool Ext.
<input type="checkbox"/> OWWO	<input type="checkbox"/> Expl	<input checked="" type="checkbox"/> Wildcat
		<input type="checkbox"/> Cable

Lease Name Matthews Well # 1
 Ground surface elevation 2300 feet MSL
 Domestic well within 330 feet: ___yes no
 Municipal well within one mile: ___yes no
 Depth to bottom of fresh water 150'
 Depth to bottom of usable water 1500' 850'
 Surface pipe by Alternate: 1 ___ 2X ___
 Surface pipe planned to be set 200'
 Conductor pipe required 4500'
 Projected Total Depth feet
 Formation Miss

If OWWO: old well info as follows:

Operator
 Well Name
 Comp Date Old Total Depth.....

I certify that well will comply with K.S.A. 55-101, et seq., plus eventually plugging hole to KCC specifications.

Date 9/5/88 Signature of Operator or Agent *Larry Childress* Title President

For KCC Use:

Conductor Pipe Required feet; Minimum Surface Pipe Required 200' feet per Alt. X (2)
 This Authorization Expires 3-8-89 Approved By LKM 9-8-88


EFFECTIVE DATE: 9-13-88

Must be filed with the K.C.C. five (5) days prior to commencing well
This card void if drilling not started within six (6) months of date received by K.C.C.

Important procedures to follow:

1. Notify District office before setting surface casing.
2. Set surface casing by circulating cement to the top.
3. File completion forms ACO-1 with K.C.C. within 120 days of well spud date, following instructions on ACO-1, side 1, and including copies of wireline logs.
4. Notify District office 48 hours prior to old well workover or re-entry.
5. Prior to filing Intent, prepare a proposed plugging plan in case well is D & A, then obtain approval of plan when calling district office prior to setting surface pipe.
6. Submit plugging report (CP-4) to K.C.C. after plugging is completed.
7. Obtain an approved injection docket number before disposing of salt water.
8. Notify K.C.C. within 10 days when injection commences or terminates.
9. If an alternate 2 completion, cement in the production pipe from below any usable water to surface within 120 days of spud date.

A Regular Section of Land 1 Mile = 5,280 Ft.

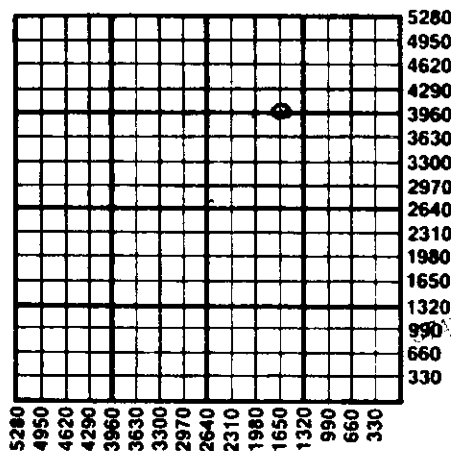

RECEIVED
STATE CORPORATION COMMISSION

SEP - 8 1988
CONSERVATION DIVISION
Wichita, Kansas

State Corporation Commission of Kansas
Conservation Division
200 Colorado Derby Building
Wichita, Kansas 67202-1212
(316) 263-3238