

CARD MUST BE TYPED

State of Kansas

CARD MUST BE SIGNED

# NOTICE OF INTENTION TO DRILL

(see rules on reverse side)

✓ DA

Expected Spud Date... June 13 1988  
month day year

API Number 15- 135-23,253-0000

OPERATOR: License # 3536

\_\_\_\_\_ East  
NW.. SE.. NW.. Sec. 12.. Twp. 20.. S. Rg. 23..  West

Name Ramco Drilling Services, Inc.

3630 Ft. from South Line of Section

Address P.O. Box 99

3630 Ft. from East Line of Section

City/State/Zip Belpre, Ohio 45714

(Note: Locate well on Section Plat on reverse side)

Contact Person Dave Goecke

Nearest lease or unit boundary line 990 feet

Phone (614) 423-9591

County Ness

CONTRACTOR: License # 5418

Lease Name Stethen, Allen, Etal. Well # 1

Name Allen Drilling Company

Ground surface elevation \_\_\_\_\_ feet MSL

City/State Great Bend, KS 67530

Domestic well within 330 feet: \_\_\_\_\_ yes  no

Well Drilled For:	Well Class:	Type Equipment:
<input checked="" type="checkbox"/> Oil	<input type="checkbox"/> Storage	<input checked="" type="checkbox"/> Mud Rotary
<input type="checkbox"/> Gas	<input type="checkbox"/> Inj	<input checked="" type="checkbox"/> Pool Ext.
<input type="checkbox"/> OWWO	<input type="checkbox"/> Expl	<input type="checkbox"/> Cable
	<input type="checkbox"/> Infield	<input type="checkbox"/> Air Rotary
	<input type="checkbox"/> Wildcat	

Municipal well within one mile: \_\_\_\_\_ yes  no

Depth to bottom of fresh water 100'

Depth to bottom of usable water 650'

Surface pipe by Alternate: \_\_\_\_\_ 1 \_\_\_\_\_ 2

Surface pipe planned to be set 200'

Conductor pipe required N/A

Projected Total Depth 4400' feet

Formation \_\_\_\_\_

If OWWO: old well info as follows:

Operator \_\_\_\_\_

Well Name \_\_\_\_\_

Comp Date \_\_\_\_\_ Old Total Depth \_\_\_\_\_

I certify that well will comply with K.S.A. 55-101, et seq., plus eventually plugging hole to KCC specifications

Date 6-8-88 Signature of Operator or Agent [Signature]

Title AGENT

For KCC Use:

Conductor Pipe Required \_\_\_\_\_ feet; Minimum Surface Pipe Required 200 feet per Alt.  ②

This Authorization Expires 12-10-88 Approved By [Signature] 6-10-88


EFFECTIVE DATE: 6-15-88

Must be filed with the K.C.C. five (5) days prior to commencing well  
This card void if drilling not started within six (6) months of date received by K.C.C.

### Important procedures to follow:

1. Notify District office before setting surface casing.
2. Set surface casing by circulating cement to the top.
3. File completion forms ACO-1 with K.C.C. within 120 days of well spud date, following instructions on ACO-1, side 1, and including copies of wireline logs.
4. Notify District office 48 hours prior to old well workover or re-entry.
5. Prior to filing Intent, prepare a proposed plugging plan in case well is D & A, then obtain approval of plan when calling district office prior to setting surface pipe.
6. Submit plugging report (CP-4) to K.C.C. after plugging is completed.
7. Obtain an approved injection docket number before disposing of salt water.
8. Notify K.C.C. within 10 days when injection commences or terminates.
9. If an alternate 2 completion, cement in the production pipe from below any usable water to surface within 120 days of spud date.

### A Regular Section of Land 1 Mile = 5,280 Ft.

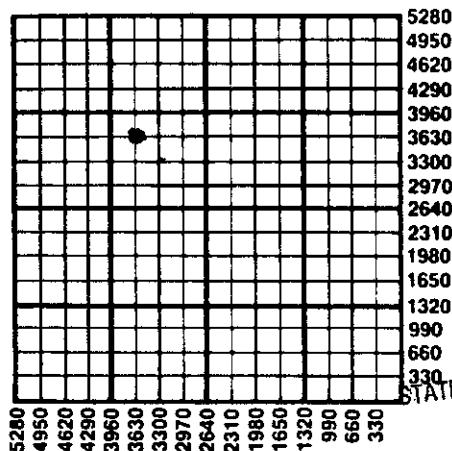

RECEIVED  
STATE CORPORATION COMMISSION

JUN - 9 1988

CONSERVATION DIVISION  
Wichita, Kansas

State Corporation Commission of Kansas  
Conservation Division  
200 Colorado Derby Building  
Wichita, Kansas 67202-1212  
(316) 263-3238