

CARD MUST BE TYPED

State of Kansas

CARD MUST BE SIGNED

NOTICE OF INTENTION TO DRILL

(see rules on reverse side)

Expected Spud Date. 7/2/88
month day yearAPI Number 15—135-23,267-0000OPERATOR: License # 5046 6033Name Raymond Oil Company, Inc./Murfin Drllg. 1980Address P. O. Box 48788City/State/Zip Wichita, Kansas 67201Contact Person. Pat RaymondPhone. 316/267-4214CONTRACTOR: License # 6033Name Murfin Drilling Co.City/State Wichita, Kansas

Well Drilled For: Well Class: Type Equipment:

☒ Oil ☐ Storage ☐ Infield ☐ Mud Rotary☐ Gas ☐ Inj ☐ Pool Ext. ☐ Air Rotary☐ OWWO ☐ Expl ☒ Wildcat ☐ Cable

If OWWO: old well info as follows:

Operator

Well Name

Comp Date Old Total Depth

I certify that well will comply with K.S.A. 55-101, et seq., plus eventually plugging hole to KCC specifications.

Date 6-30-88 Signature of Operator or Agent Pat Raymond

For KCC Use:

Conductor Pipe Required feet; Minimum Surface Pipe Required

This Authorization Expires 12-30-88C NW SW Sec 28 Twp 20 S, Rg. 23 ☒ East ☒ West

Ft. from South Line of Section

4620 Ft. from East Line of Section

(Note: Locate well on Section Plat on reverse side)

Nearest lease or unit boundary line 660 feet

County NessLease Name Burdett Well # 1Ground surface elevation est. 2222 feet MSLDomestic well within 330 feet: ☐ yes ☒ noMunicipal well within one mile: ☐ yes ☒ no

Depth to bottom of fresh water 75'

Depth to bottom of usable water 350' 650'

Surface pipe by Alternate: 1 ☐ 2 ☒

Surface pipe planned to be set 650' 350'

Conductor pipe required None

Projected Total Depth 4450 feet


Formation MississippiTitle Vice PresidentApproved By Pat Raymondfeet per Alt. 200Approved By Pat RaymondEFFECTIVE DATE: 7-5-88

Must be filed with the K.C.C. five (5) days prior to commencing well
This card void if drilling not started within six (6) months of date received by K.C.C.

Important procedures to follow:

1. Notify District office before setting surface casing.
2. Set surface casing by circulating cement to the top.
3. File completion forms ACO-1 with K.C.C. within 120 days of well spud date, following instructions on ACO-1, side 1, and including copies of wireline logs.
4. Notify District office 48 hours prior to old well workover or re-entry.
5. Prior to filing Intent, prepare a proposed plugging plan in case well is D & A, then obtain approval of plan when calling district office prior to setting surface pipe.
6. Submit plugging report (CP-4) to K.C.C. after plugging is completed.
7. Obtain an approved injection docket number before disposing of salt water.
8. Notify K.C.C. within 10 days when injection commences or terminate.
9. If an alternate 2 completion, cement in the production pipe from below any usable water to surface within 120 days of spud date.

A Regular Section of Land
1 Mile = 5,280 Ft.

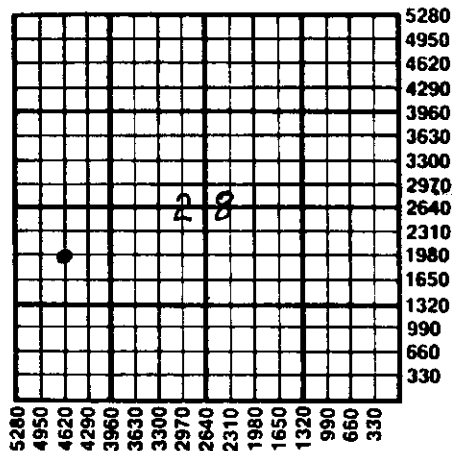

RECEIVED
STATE CORPORATION COMMISSION

JUN 3 0 1988

CONSERVATION DIVISION
Wichita, Kansas

State Corporation Commission of Kansas
Conservation Division
200 Colorado Derby Building
Wichita, Kansas 67202-1212
(316) 263-3238