

CARD MUST BE TYPED

State of Kansas  
**NOTICE OF INTENTION TO DRILL**

CARD MUST BE SIGNED

(see rules on reverse side)

Starting Date: 06/19/84  
month day year

API Number 15- 101-20,995-0000

OPERATOR: License # 5181  
Name DONALD C. SLAWSON  
Address 200 Douglas Building  
City/State/Zip Wichita, KS 67202  
Contact Person Bill Harigan  
Phone 316-263-3201

NW NE NE Sec 11 Twp 16 S, Rge 30W  East  
(location)  West  
4950 Ft North from Southeast Corner of Section  
1020 Ft West from Southeast Corner of Section  
(Note: Locate well on Section Plat on reverse side)

CONTRACTOR: License # 5657  
Name SLAWSON DRILLING CO., INC.  
City/State Wichita, KS 67202

Nearest lease or unit boundary line 330 feet.  
County Lane  
Lease Name York 'KK' Well# 1

Well Drilled For: Well Class: Type Equipment:  
 Oil  Swd  Infield  Mud Rotary  
 Gas  Inj  Pool Ext.  Atr Rotary  
 OWWO  Expl  Wildcat  Cable

Domestic well within 330 feet:  yes  no  
Municipal well within one mile:  yes  no

If OWWO: old well info as follows:

Operator  
Well Name  
Comp Date Old Total Depth  
Projected Total Depth 4400 feet  
Projected Formation at TD Mississippian  
Expected Producing Formations LANS/KC, MARM, CHER

Depth to Bottom of fresh water 90 feet  
Lowest usable water formation Dakota  
Depth to Bottom of usable water 1100 feet  
Surface pipe by Alternate: 1  2   
Surface pipe to be set 360 feet  
Conductor pipe if any required  
Ground surface elevation 2701 feet MSL  
This Authorization Expires 12-18-84  
Approved By 6-18-84

I certify that we will comply with K.S.A. 55-101, et seq., plus eventually plugging hole to M.C.C. specifications.

Date 06/18/84  
Signature of Operator or Agent

*Theodore Sandberg*  
J. THEODORE SANDBERG Title Division Mgr./Geol.


Must be filed with the K.C.C. five (5) days prior to commencing well  
This card void if drilling not started within six (6) months of date received by K.C.C.

RECEIVED  
STATE CORPORATION COMMISSION

6-18-84  
JUN 1 1984

A Regular Section of Land  
1 Mile = 5,280 Ft.

CONSERVATION  
Wichita, Kz

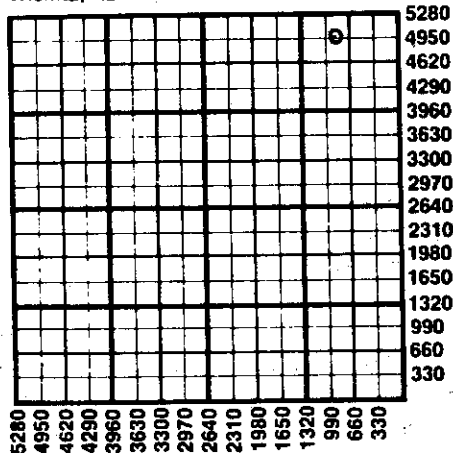

Important procedures to follow:

1. Notify District office before setting surface casing.
2. Set surface casing by circulating cement to the top.
3. File completion forms ACO-1 with K.C.C. within 90 days of well completion, following instructions on ACO-1, side 1, and including copies of wireline logs.
4. Notify District office 48 hours prior to old well workover or re-entry.
5. Prior to plugging, ~~prepare a plugging plan,~~ then obtain agreement from the appropriate district office for an approved plugging plan.
6. Submit plugging report (CP-4) to K.C.C. after plugging is completed.
7. Obtain an approved injection docket number before disposing of salt water.
8. Notify K.C.C. within 10 days when injection commences or terminates.
- \* ~~9. If an alternate 2 completion, cement in the production pipe from below any usable water to surface within 120 days of spud date.~~

State Corporation Commission of Kansas  
Conservation Division  
200 Colorado Derby Building  
Wichita, Kansas 67202

\* Not consistent with rules & regulations. (316) 263-3238