

CORRECTION
CARD MUST BE SIGNED

(see rules on reverse side)

Starting Date: 9 12 1984
month day year

API Number 15- 101-21,040-0000

OPERATOR: License # 6113
Name Landmark Oil Exploration, Inc.
Address 105 S. Broadway, Suite 1040
City/State/Zip Wichita, Kansas 67202
Contact Person Mel Hussey
Phone 316-265-8181

CONTRACTOR: License #5420.....
 Name ..White.&.Ellis.Drilling,.Inc.....
 City/StateWichita,.Kansas...67202.....

Well Drilled For:	Well Class:	Type Equipment:
☒ Oil ☐ Swd	☐ Infield	☒ Mud Rotary
☐ Gas ☐ Inj	☒ Pool Ext.	☐ Air Rotary
☐ OWWO ☐ Expl	☒ Wildcat	☐ Cable

If OWWO: old well info as follows:

Operator
Well Name
Comp Date Old Total Depth
Projected Total Depth 4500' feet
Projected Formation at TD Mississippi
Expected Producing Formations Lansing/Kansas City

I certify that we will comply with K.S.A. 55-101, et seq., plus eventually plugging hole to K.C.C. specifications.

Date 8-31-84 Signature of Operator or Agent _____

Merlin C. Hussey

N. 130' E. C. NW. SE NE 8. 16 ☐ East
(location) Sec . . . Twp . . . S, Rge . . . ☒ West

....3670..... Ft North from Southeast Corner of Section

.....860..... Ft West from Southeast Corner of Section

(Note: Locate well on Section Plat on reverse side)

Nearest lease or unit boundary line860..... feet.

County Lane /

Lease NameDoll..... Well# 2-8.....

Domestic well within 330 feet : ☐ yes ☒ no

Municipal well within one mile : ☐ yes ☒ no

Depth to Bottom of fresh water ...200..... feet

Lowest usable water formation Dakota

Depth to Bottom of usable water 1100 feet

Surface pipe by Alternate : 1 ☐ 2 ☒

Surface pipe to be set 250 feet

Conductor pipe if any requiredNone..... feet

Ground surface elevation feet MSL

This Authorization Expires 3-4-85.....

Approved By 9-4-84 [Signature]

Exploration Manager


Form C-1 4/84

mic/rohe 9/4/84

Must be filed with the K.C.C. five (5) days prior to commencing well
This card void if drilling not started within six (6) months of date received by K.C.C.

Important procedures to follow:

A Regular Section of Land
1 Mile = 5,280 Ft.

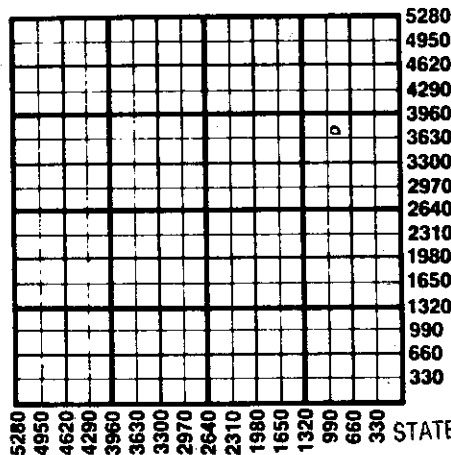

1. Notify District office before setting surface casing.
2. Set surface casing by circulating cement to the top.
3. File completion forms ACO-1 with K.C.C. within 90 days of well completion, following instructions on ACO-1, side 1, and including copies of wireline logs.
4. Notify District office 48 hours prior to old well workover or re-entry.
5. Prior to plugging, prepare a plugging plan, then obtain agreement from the appropriate district office for an approved plugging plan.
6. Submit plugging report (CP-4) to K.C.C. after plugging is completed.
7. Obtain an approved injection docket number before disposing of salt water.
8. Notify K.C.C. within 10 days when injection commences or terminates.
9. If an alternate 2 completion, cement in the production pipe from below and usable water to surface within 120 days of spud date.

RECEIVED

STATE CORPORATION COMMISSION

State Corporation Commission of Kansas

Conservation Division

200 Colorado Derby Building

Wichita, Kansas 67202

(316) 263-3238

SEP 04 1984
9-4-84
CONSERVATION DIVISION
Wichita, Kansas