

CARD MUST BE TYPED

State of Kansas

CARD MUST BE SIGNED

NOTICE OF INTENTION TO DRILL

(see rules on reverse side)

Starting Date 12 month 11 day 86 year

OPERATOR: License # 5011
Name Viking Resources
Address 217 E. William
City/State/Zip Wichita, KS 67202-4005
Contact Person Jim Devlin
Phone (316) 262-2502

CONTRACTOR: License # 06907
Name Hembree Well Service, Inc.
City/State Ness City, KS 67560

Well Drilled For: Oil [X] SWD, Gas [ ] Inj, OWWO [X]
Well Class: Infield [ ] Pool Ext. [ ] Wildcat [ ]
Type Equipment: Mud Rotary [ ] Air Rotary [ ] Cable [ ]

If OWWO: old well info as follows:
Operator Thunderbird Drilling, Inc.
Well Name #1 Ramsey
Comp Date 1-28-78 Old Total Depth 2100

I certify that well will comply with K.S.A. 55-101, et seq., plus eventually plugging hole to KCC specifications.
Date 8 Dec. 1986 Signature of Operator or Agent James B. Devlin Title Operator

For KCC Use:
Conductor Pipe Required ... feet; Minimum Surface Pipe Required ... feet per Alt. 4
This Authorization Expires 6-9-87 Approved By 12-9-86

API Number 15-171-20,156-0001
150' NW of C NE NE Sec. 1 Twp. 18 S, Rg. 31
4726 Ft. from South Line of Section
766 Ft. from East Line of Section

(Note: Locate well on Section Plat on reverse side)
Nearest lease or unit boundary line 554' feet
County Scott
Lease Name Ramsey Well # 1-SWD
Ground surface elevation 2900 feet MSL
Domestic well within 330 feet: yes [ ] no [X]
Municipal well within one mile: yes [ ] no [X]
Depth to bottom of fresh water 150
Depth to bottom of usable water 1600
Surface pipe by Alternate: 1-2 [X]
Surface pipe planned set 260' w/225 sks
Conductor pipe required
Projected Total Depth 2050 feet
Formation Cedar Hills
4" set @ 2088' w/450 sks

Handwritten signature and initials at bottom right of the document.

Must be filed with the K.C.C. five (5) days prior to commencing well  
 This card void if drilling not started within six (6) months of date received by K.C.C.


**Important procedures to follow:**

1. Notify District office before setting surface casing.
2. Set surface casing by circulating cement to the top.
3. File completion forms ACO-1 with K.C.C. within 90 days of well completion, following instructions on ACO-1, side 1, and including copies of wireline logs.
4. Notify District office 48 hours prior to old well workover or re-entry.
5. Prior to filing Intent, prepare a proposed plugging plan in case well is D & A, then obtain approval of plan when calling district office prior to setting surface pipe.
6. Submit plugging report (CP-4) to K.C.C. after plugging is completed.
7. Obtain an approved injection docket number before disposing of salt water.
8. Notify K.C.C. within 10 days when injection commences or terminates.
9. If an alternate 2 completion, cement in the production pipe from below any usable water to surface within 120 days of spud date.

**A Regular Section of Land**  
 1 Mile = 5,280 Ft.

STATE CORPORATION COMMISSION

DEC 9 1985  
 12-9-86  
 CONSERVATION DIVISION  
 Wichita, Kansas

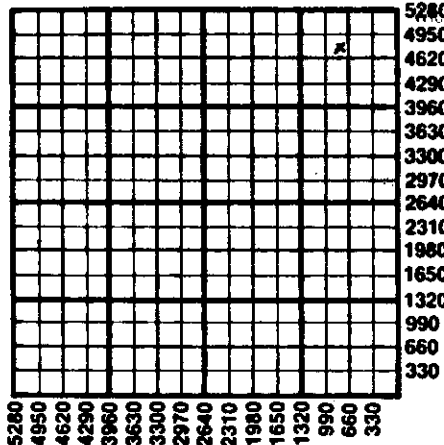

State Corporation Commission of Kansas  
 Conservation Division  
 200 Colorado Derby Building  
 Wichita, Kansas 67202  
 (316) 263-3238