

FOR KCC USE:

FORM C-1 7/91

FORM MUST BE TYPED

FORM MUST BE SIGNED

ALL BLANKS MUST BE FILLED

EFFECTIVE DATE: 4-9-96

State of Kansas

DISTRICT # 1

NOTICE OF INTENTION TO DRILL

SGA? Yes / No

Must be approved by the K.C.C. five (5) days prior to commencing well.

Expected Spud Date 04 month 29 day 96 year Spot NW/4 - NW/4 - SW/4 Sec ..6.. Twp ..18. S, Rg .31.. X East X West

OPERATOR: License # 4243
Name: CROSS.BAR PETROLEUM, INC.
Address: 151 N. MAIN, SUITE 630
City/State/Zip: WICHITA, KS 67202-1407
Contact Person: ALBERT BRENSING
Phone: 316-265-2279

2310 feet from South / xxxxh line of Section
330 feet from West / line of Section
IS SECTION X REGULAR IRREGULAR?

(NOTE: Locate well on the Section Plat on Reverse Side)
County: SCOTT

Lease Name: HUCK Well #: 1-6
Field Name: BECKLEY NORTH FIELD

Is this a Prorated/Spaced Field? yes X no

Target Formation(s): MISSISSIPPIAN
Nearest lease or unit boundary: 330'

Ground Surface Elevation: Est. 2964 feet MSL
Water well within one-quarter mile: yes X no

Public water supply well within one mile: yes X no
Depth to bottom of fresh water: 160 180

Depth to bottom of usable water: 160 1720
Surface Pipe by Alternate: X 1 X 2

Length of Surface Pipe Planned to be set: 275'
Length of Conductor pipe required: N/A

Projected Total Depth: 4700'
Formation at Total Depth: Mississippian

Water Source for Drilling Operations:
well farm pond X other

CONTRACTOR: License #: ADVISE ON ACO-1
Name: Unknown

Well Drilled For:	Well Class:	Type Equipment:
<u>X</u> Oil	<u>Enh Rec</u>	<u>Infield</u> <u>X</u> Mud Rotary
<u>Gas</u>	<u>Storage</u>	<u>X</u> Pool Ext. <u>Air Rotary</u>
<u>OWWO</u>	<u>Disposal</u>	<u>Wildcat</u> <u>Cable</u>
<u>Seismic;</u>	<u># of Holes</u>	<u>Other</u>
<u>Other</u>		

If OWWO: old well information as follows:
Operator: _____
Well Name: _____
Comp. Date: _____ Old Total Depth _____

Directional, Deviated or Horizontal wellbore? yes X no
If yes, true vertical depth: _____
Bottom Hole Location: _____

Will Cores Be Taken?: yes X no
If yes, proposed zone: _____

AFFIDAVIT

The undersigned hereby affirms that the drilling, completion and eventual plugging of this well will comply with Kansas Statutes 55-101, et. seq.
It is agreed that the following minimum requirements will be met:

1. Notify the appropriate district office prior to spudding of well;
2. A copy of the approved notice of intent to drill shall be posted on each drilling rig;
3. The minimum amount of surface pipe as specified below shall be set by circulating cement to the top; in all cases surface pipe shall be set through all unconsolidated materials plus a minimum of 20 feet into the underlying formation;
4. If the well is dry hole, an agreement between the operator and the district office on plug length and placement is necessary prior to plugging;
5. The appropriate district office will be notified before well is either plugged or production casing is cemented in;
6. IF AN ALTERNATE II COMPLETION, PRODUCTION PIPE SHALL BE CEMENTED FROM BELOW ANY USABLE WATER TO SURFACE WITHIN 120 DAYS OF SPUD DATE. IN ALL CASES, NOTIFY DISTRICT OFFICE PRIOR TO ANY CEMENTING.

I hereby certify that the statements made herein are true and to the best of my knowledge and belief.
Date: 4-04-96 Signature of Operator or Agent: Jo Ann Thaden Title: Jo Ann Thaden, Prod. Admin.

RECEIVED
KANSAS CORPORATION WITH KANSAS
4-4-96
APR 04 1996

FOR KCC USE:
API # 15- 171-204970000
Conductor pipe required NONE feet
Minimum surface pipe required 200 feet per Alt. X ②
Approved by: JV 4-4-96
This authorization expires: 10-4-96
(This authorization void if drilling not started within 6 months of effective date.)
Spud date: _____ Agent: _____

REMEMBER TO:

- File Drill Pit Application (form CDP-1) with Intent to Drill;
- File Completion Form ACO-1 within 120 days of spud date;
- File acreage attribution plat according to field proration orders;
- Notify appropriate district office 48 hours prior to workover or re-entry;
- Submit plugging report (CP-4) after plugging is completed;
- Obtain written approval before disposing or injecting salt water.

Mail to: KCC - Conservation Division, 130 S. Market - Room 2078, Wichita, Kansas 67202.

6
18
S/W

IN ALL CASES PLOT THE INTENDED WELL ON THE PLAT BELOW

PLAT OF ACREAGE ATTRIBUTABLE TO A WELL IN A PRORATED OR SPACED FIELD


If the intended well is in a prorated or spaced field, please fully complete this side of the form. If the intended well is in a prorated or spaced field complete the plat below showing that the well will be properly located in relationship to other wells producing from the common source of supply. Please show all the wells within 1 mile of the boundaries of the proposed acreage attribution unit for gas wells and within 1/2 mile of the boundaries of the proposed acreage attribution unit for oil wells.

API NO. 15- _____
 OPERATOR: CROSS BAR PETROLEUM, INC. _____
 LOCATION OF WELL: COUNTY SCOTT _____
 LEASE HUCK _____ 2310 feet from south/xxxxx line of section
 WELL NUMBER #1-6 _____ 330 feet from xxxx/west line of section
 FIELD BECKLEY NORTH FIELD _____ SECTION 6 TWP 18S RG 31W _____

NUMBER OF ACRES ATTRIBUTABLE TO WELL 160 IS SECTION X REGULAR or IRREGULAR
 QTR/QTR/QTR OF ACREAGE NW - NW - SW **IF SECTION IS IRREGULAR, LOCATE WELL FROM NEAREST CORNER BOUNDARY.**
 Section corner used: NE NW SE x SW

PLAT

(Show location of the well and shade attributable acreage for prorated or spaced wells.)
 (Show footage to the nearest lease or unit boundary line.)

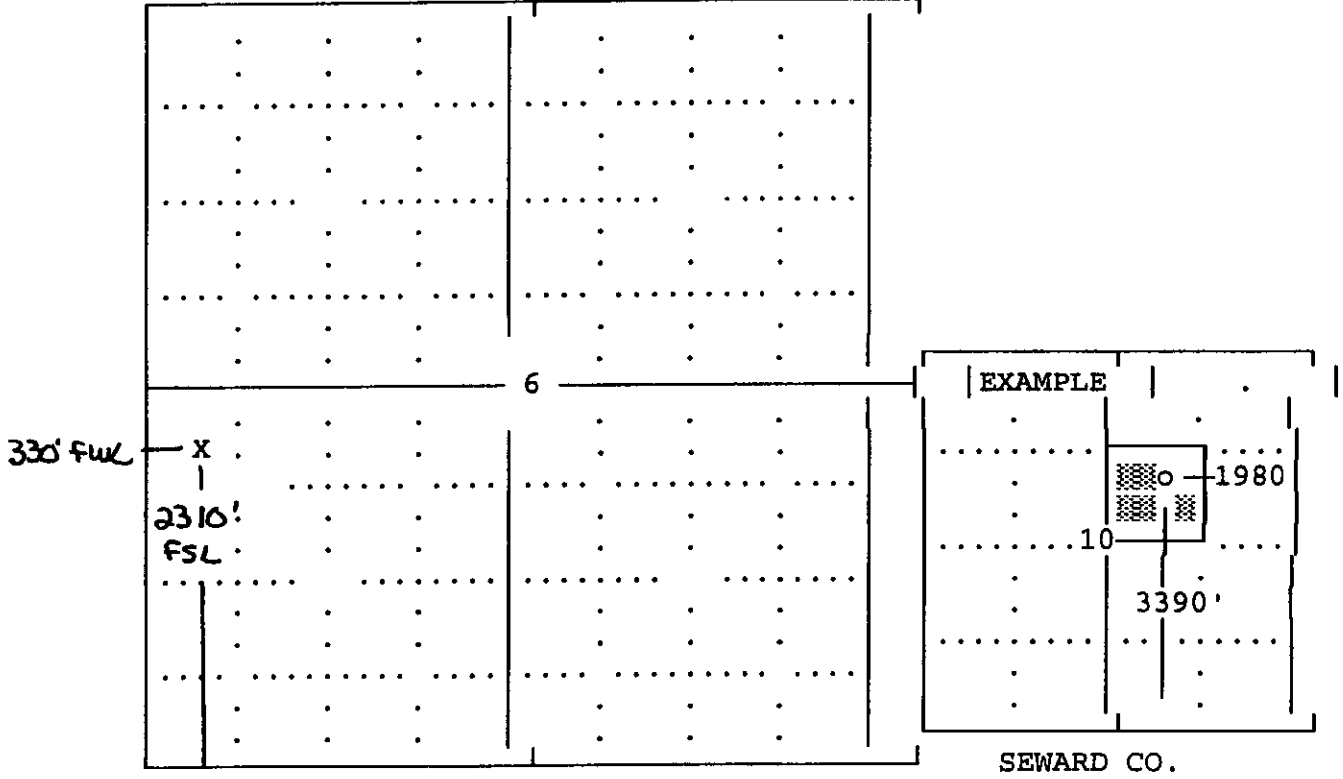

T18S-R31W, SCOTT CO., KS

In plotting the proposed location of the well, you must show:

- 1) The manner in which you are using the depicted plat by identifying section lines, i.e. 1 section, 1 section with 8 surrounding sections, 4 sections, etc.;
- 2) the distance of the proposed drilling location from the section's south/north and east/west; and
- 3) the distance to the nearest lease or unit boundary line.