

CARD MUST BE SIGNED

(see rules on reverse side)

API Number 15— 125-28,297-0000

SE Sec. 17 Twp. 34 S, Rg. 14 X East
— West
825 Ft. from South Line of Section
2145 Ft. from East Line of Section

(Note: Locate well on Section Plat on reverse side)

Nearest lease or unit boundary line 495 feet
County... MONTGOMERY

Lease Name.....POWELL..... Well #..KP-15.....
Ground surface elevationfeet MSL

Domestic well within 330 feet: _____yes **X**_____no

Domestic well within 330 feet: yes **X** no

Municipal well within one mile: yes Xno

Surface pipe by Alternate: 1 2 X

Depth to bottom of fresh water.....100

Depth to bottom of usable water 175

Surface pipe planned to be set 20

Projected Total Depth 1330 feet

Formation.....Bartlesville

I certify that well will comply with K.S.A. 55-101, et seq., plus eventually plugging hole to KCC specifications.

_____ cementing will be done immediately upon setting production casing.

Date 3-7-86 Signature of Operator or Agent Frank Brundage Title _____ Agent 7

For KCC Use:

Conductor Pipe Required feet; Minimum Surface Pipe Required feet per ft. $\times (2)$


This Authorization Expires.....7-7-86..... Approved By3-7-86.....[Signature].....

Must be filed with the K.C.C. five (5) days prior to commencing well
This card void if drilling not started within six (6) months of date received by K.C.C.

Important procedures to follow:

1. Notify District office before setting surface casing.
2. Set surface casing by circulating cement to the top.
3. File completion forms ACO-1 with K.C.C. within 90 days of well completion, following instructions on ACO-1, side 1, and including copies of wireline logs.
4. Notify District office 48 hours prior to old well workover or re-entry.
5. Prior to filing Intent, prepare a proposed plugging plan in case well is D & A, then obtain approval of plan when calling district office prior to setting surface pipe.
6. Submit plugging report (CP-4) to K.C.C. after plugging is completed.
7. Obtain an approved injection docket number before disposing of salt water.
8. Notify K.C.C. within 10 days when injection commences or terminates.

A Regular Section of Land 1 Mile = 5,280 Ft.

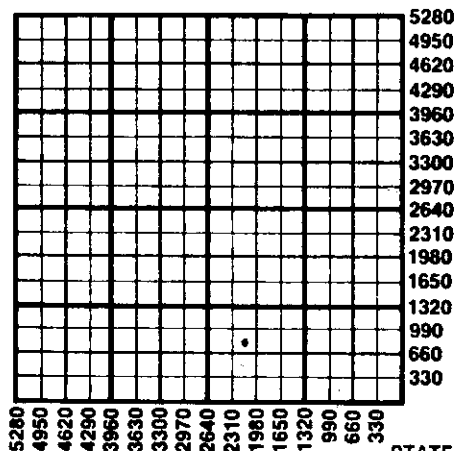

RECEIVED
STATE CORPORATION COMMISSION

MAR 7 - 1986

CONSERVATION DIVISION
Wichita, Kansas

If an alternate 2 completion, cement in the production pipe from
below any usable water to surface within 120 days of spud date.

State Corporation Commission of Kansas
Conservation Division
200 Colorado Derby Building
Wichita, Kansas 67202
(316) 263-3238