

CARD MUST BE TYPED

State of Kansas
NOTICE OF INTENTION TO DRILL

CARD MUST BE SIGNED

(see rules on reverse side)

Starting Date: 07 / 03 / 86
month day year

API Number 15- 101-21,323-0000

OPERATOR: License # 7245 [redacted] & 4087
Name Texas-El Dorado Oil Co. [redacted] & Williamson Drllg.
Address 550 W. Central, Suite 1108
City/State/Zip Wichita, KS 67203
Contact Person K. Wiese
Phone (316) 263-6853

SW NE NE Sec 1 Twp 16 S, Rge 30
4290 Ft North from Southeast Corner of Section
990 Ft West from Southeast Corner of Section
(Note: Locate well on Section Plat on reverse side)

East
 West

CONTRACTOR: License # 4087
Name Williamson Drilling, Inc.
City/State Great Bend, KS

Nearest lease or unit boundary line 990 feet.
County Lane
Lease Name Rush Well# 1-1
Domestic well within 330 feet: yes no
Municipal well within one mile: yes no

Well Drilled For: Well Class: Type Equipment:
 Oil Swd Infield Mud Rotary
 Gas Inj Pool Ext. Air Rotary
 OWWO Expl Wildcat Cable

~~XIKOMONK HICEDDMSHOLUD~~ (2/3 mi. from prod., sep. by dry holes)

Well Name
Comp Date Old Total Depth
Projected Total Depth 4450 feet
Projected Formation at TD Mississippian
Expected Producing Formations unknown

Depth to Bottom of fresh water feet
Lowest usable water formation Dakota feet
Depth to Bottom of usable water 1100 feet
Surface pipe by Alternate: 1 2
Surface pipe to be set 350 feet
Conductor pipe if any required NR feet
Ground surface elevation 2670 (est.) feet MSL
This Authorization Expires 12-30-86
Approved By 6-30-86

I certify that we will comply with K.S.A. 55-101, et seq., plus eventually plugging hole to K.C.C. specifications.


Date 30 Jun 86 Signature of Operator or Agent [Signature] Title

Rec'd
6-30-86

Must be filed with the K.C.C. five (5) days prior to commencing well
This card void if drilling not started within six (6) months of date received by K.C.C.

[REDACTED] important procedures to follow:

A Regular Section of Land
1 Mile = 5,280 Ft.

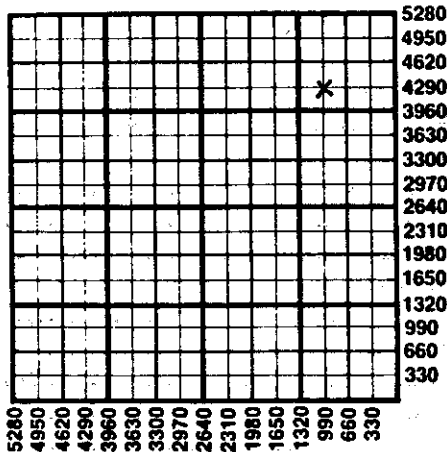

1. Notify District office before setting surface casing.
2. Set surface casing by circulating cement to the top.
3. File completion forms ACO-1 with K.C.C. within 90 days of well completion, following instructions on ACO-1, side 1, and including copies of wireline logs.
4. Notify District office 48 hours prior to old well workover or re-entry.
5. Prior to plugging, prepare a plugging plan, then obtain agreement from the appropriate district office for an approved plugging plan.
6. Submit plugging report (CP-4) to K.C.C. after plugging is completed.
7. Obtain an approved injection docket number before disposing of salt water.
8. Notify K.C.C. within 10 days when injection commences or terminates.
9. If an alternate 2 completion, cement in the production pipe from below any usable water to surface within 120 days of spud date.

State Corporation Commission of Kansas
Conservation Division
200 Colorado Derby Building
Wichita, Kansas 67202
(316) 263-3238