

CARD MUST BE TYPED

State of Kansas  
**NOTICE OF INTENTION TO DRILL**  
(see rules on reverse side)

CARD MUST BE SIGNED

Starting Date: October 30, 1984  
month day year

API Number IS- 101-21,075-0000

OPERATOR: License # 5181  
Name DONALD C. SLAWSON  
Address 200 Douglas Bldg.  
City/State/Zip Wichita, Kansas 67202  
Contact Person Bill Horigan  
Phone (316)263-3201

NE SW SE Sec 1 Twp 16S S, Rge 30W  East  
(location)  West

990 Ft North from Southeast Corner of Section  
1650 Ft West from Southeast Corner of Section  
(Note: Locate well on Section Plat on reverse side)

CONTRACTOR: License # 5657  
Name Slawson Drilling Co., Inc.  
City/State Wichita, Kansas

Nearest lease or unit boundary line 990 feet.  
County Lane  
Lease Name Jasper 'J' Well# 1

Well Drilled For: Well Class: Type Equipment:  
 Oil  Swd  Infield  Mud Rotary  
 Gas  Inj  Pool Ext.  Air Rotary  
 OWWO  Expl  Wildcat  Cable

Domestic well within 330 feet:  yes  no  
Municipal well within one mile:  yes  no

If OWWO: old well info as follows:

Operator .....  
Well Name .....  
Comp Date ..... Old Total Depth .....  
Projected Total Depth 4400 feet  
Projected Formation at TD MISS  
Expected Producing Formations LKC/MARM/CHER

Depth to Bottom of fresh water 90' feet  
Lowest usable water formation Dakota  
Depth to Bottom of usable water 1050' feet  
Surface pipe by Alternate: 1 2 3  
Surface pipe to be set 360' feet  
Conductor pipe if any required ..... feet  
Ground surface elevation 2704 feet MSL  
This Authorization Expires 4-29-85  
Approved By 10-29-84 *R.*

I certify that we will comply with K.S.A. 55-101, et seq., plus eventually plugging hole to K.C.C. specifications.

Date 10/26/84 Signature of Operator or Agent

*Theodore Sandberg*  
J. Theodore Sandberg


Div. Mgr./Geologist

*MHC/NDHE 10/29/84*  
Form C-1 4/84

Must be filed with the K.C.C. five (5) days prior to commencing well  
 This card void if drilling not started within six (6) months of date received by K.C.C.

10-29-84  
 OCT 29 1984

A Regular Section of LAND CONSERVATION DIVISION  
 1 Mile = 5,280 Feet, Kansas

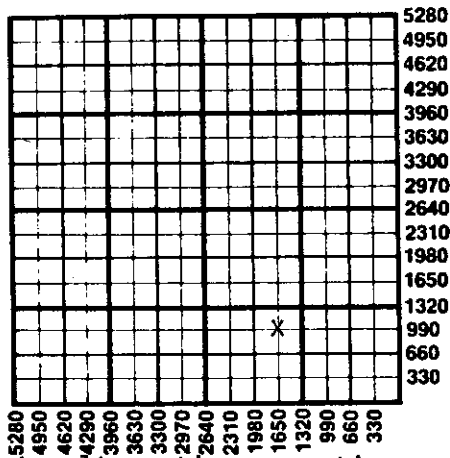

**Important procedures to follow :**

1. Notify District office before setting surface casing.
2. Set surface casing by circulating cement to the top.
3. File completion forms ACO-1 with K.C.C. within 90 days of well completion, following instructions on ACO-1, side 1, and including copies of wireline logs.
4. Notify District office 48 hours prior to old well workover or re-entry.
5. Prior to plugging, prepare a plugging plan, then obtain agreement from the appropriate district office for an approved plugging plan.
6. Submit plugging report (CP-4) to K.C.C. after plugging is completed.
7. Obtain an approved injection docket number before disposing of salt water.
8. Notify K.C.C. within 10 days when injection commences or terminates.
- \*9. If an alternate 2 completion, cement in the production pipe from below any usable water to surface within 120 days of spud date.

\*Circulate alternative cementing material per 82-3-106(b)4 Conservation Division

State Corporation Commission of Kansas  
 200 Colorado Derby Building  
 Wichita, Kansas 67202  
 (316) 263-3238