

CARD MUST BE TYPED

State of Kansas

CARD MUST BE SIGNED

**\*CORRECTION**

# NOTICE OF INTENTION TO DRILL

**\*CORRECTION**

(see rules on reverse side)

Expected Spud Date. July 16, 1987  
month day year

API Number 15- 135-23, 140-0000

OPERATOR: License # 3447  
Name RANKEN ENERGY CORPORATION  
Address 2932 N.W. 122nd, Suite #18  
City/State/Zip Oklahoma City, Oklahoma 73120  
Contact Person GARY MISAK  
Phone (316) 792-3664

**\*50'** east S/2 SW/4 SW/4 Sec. 28 Twp. 20 S, Rg 24 East  
330' Ft. from South Line of Section  
**\*4570'** Ft. from East Line of Section

(Note: Locate well on Section Plat on reverse side)

Nearest lease or unit boundary line 330' feet  
County NESS

Lease Name OTTE Well # 1

Ground surface elevation 2350 feet MSL

Domestic well within 330 feet:     yes X no

Municipal well within one mile:     yes X no

Depth to bottom of fresh water. 75'

Depth to bottom of usable water 710'

Surface pipe by Alternate:     1 X 2    

Surface pipe planned to be set 730'

Conductor pipe required    

Projected Total Depth 4,450' feet

Formation MISSISSIPPIAN

**\*CONTRACTOR:** License #      
Name EMPHASIS oil Operations  
City/State Russell, Kansas

Well Drilled For: Well Class: Type Equipment:  
X Oil     Storage     Infield X Mud Rotary  
    Gas     Inj     Pool Ext.     Air Rotary  
    OWWO     Expl X Wildcat     Cable

If OWWO: old well info as follows:

Operator      
Well Name      
Comp Date     Old Total Depth    

I certify that well will comply with K.S.A. 55-101, et seq., plus eventually plugging hole to KCC specifications.

Date July 21, 1987 Signature of Operator or Agent Randolph L. Coy Title Randolph L. Coy, President

For KCC Use:

Conductor Pipe Required     feet; Minimum Surface Pipe Required 730 feet per Alt. 1

This Authorization Expires 1-01-88 Approved By Per 7-24-87


WAS: C S/2 SW SW, 4620' FEL, Contractor: Not Known / ORIG. REV'D 7-1-87

Must be filed with the K.C.C. five (5) days prior to commencing well  
 This card void if drilling not started within six (6) months of date received by K.C.C.

**Important procedures to follow:**

1. Notify District office before setting surface casing.
2. Set surface casing by circulating cement to the top.
3. File completion forms ACO-1 with K.C.C. within 120 days of well spud date, following instructions on ACO-1, side 1, and including copies of wireline logs.
4. Notify District office 48 hours prior to old well workover or re-entry.
5. Prior to filing Intent, prepare a proposed plugging plan in case well is D & A, then obtain approval of plan when calling district office prior to setting surface pipe.
6. Submit plugging report (CP-4) to K.C.C. after plugging is completed.
7. Obtain an approved injection docket number before disposing of salt water.
8. Notify K.C.C. within 10 days when injection commences or terminates.
9. If an alternate 2 completion, cement in the production pipe from below any usable water to surface within 120 days of spud date.

**A Regular Section of Land  
 1 Mile = 5,280 Ft.**

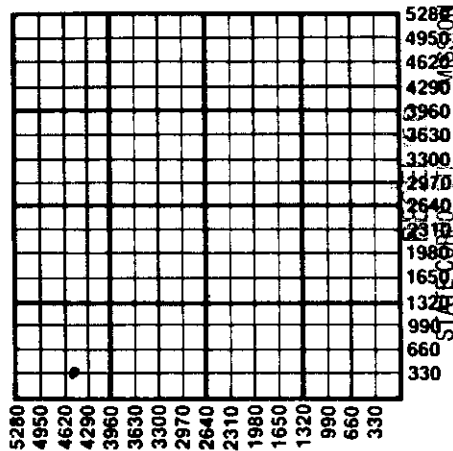

JUL 22 1987

CONSERVATION DIVISION  
 Wichita, Kansas

State Corporation Commission of Kansas  
 Conservation Division  
 200 Colorado Derby Building  
 Wichita, Kansas 67202-1212  
 (316) 263-3238