

CARD MUST BE TYPED

State of Kansas

CARD MUST BE SIGNED

NOTICE OF INTENTION TO DRILL

(see rules on reverse side)

Starting Date September 21, 1987
month day year

API Number 15-171-20,364-0000

OPERATOR: License # 4197
Name Dunne Oil Co.
Address 100 S. Main, Suite 520
City/State/Zip Wichita Kansas 67202
Contact Person Stephen W. Dunne
Phone 316-267-3448

C NE NW Sec 12 Twp 18 S, Rg 31 East
4,620 Ft. from South Line of Section
3,300 Ft. from East Line of Section

(Note: Locate well on Section Plat on reverse side)

CONTRACTOR: License # 5883
Name Warrior Drilling Co.
City/State Wichita Kansas

Nearest lease or unit boundary line 660 feet
County Scott
Lease Name Janssen Well # 1-12

Well Drilled For: Well Class: Type Equipment:
 Oil SWD Infield Mud Rotary
 Gas Inj Pool Ext. Air Rotary
 OWWO Expl Wildcat Cable

Ground surface elevation 2,900 feet MSL
Domestic well within 330 feet: yes no
Municipal well within one mile: yes no

If OWWO: old well info as follows:

Depth to bottom of fresh water 120'
Depth to bottom of usable water 1,525'
Surface pipe by Alternate: 1 2

Operator
Well Name
Comp Date Old Total Depth

Surface pipe planned to be set 200'
Conductor pipe required none
Projected Total Depth 4,600 feet
Formation Mississippi

I certify that well will comply with K.S.A. 55-101, et seq., plus eventually plugging hole to KCC specifications.

Date 9/11/87 Signature of Operator or Agent Title President

For KCC Use:

Conductor Pipe Required feet; Minimum Surface Pipe Required 200 feet per Alt. X 2


This Authorization Expires 3-15-88 Effective 9-20-87 Approved By A.A. 9-15-87

Must be filed with the K.C.C. five (5) days prior to commencing well
This card void if drilling not started within six (6) months of date received by K.C.C.

Important procedures to follow:

1. Notify District office before setting surface casing.
2. Set surface casing by circulating cement to the top.
3. File completion forms ACO-1 with K.C.C. within 90 days of well completion, following instructions on ACO-1, side 1, and including copies of wireline logs.
4. Notify District office 48 hours prior to old well workover or re-entry.
5. Prior to filing Intent, prepare a proposed plugging plan in case well is D & A, then obtain approval of plan when calling district office prior to setting surface pipe.
6. Submit plugging report (CP-4) to K.C.C. after plugging is completed.
7. Obtain an approved injection docket number before disposing of salt water.
8. Notify K.C.C. within 10 days when injection commences or terminates.
9. If an alternate 2 completion, cement in the production pipe from below any usable water to surface within 120 days of spud date.

A Regular Section of Land 1 Mile = 5,280 Ft.

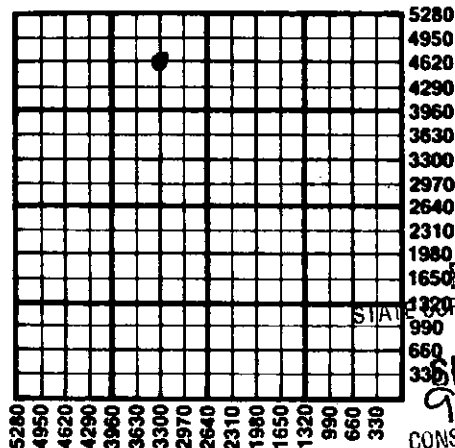

State Corporation Commission of Kansas
Conservation Division
200 Colorado Derby Building
Wichita, Kansas 67202
(316) 263-3238