

CARD MUST BE TYPED

State of Kansas
NOTICE OF INTENTION TO DRILL

CARD MUST BE SIGNED

(see rules on reverse side)

Starting Date: July 28, 1984
month day year 3/15

API Number 15- 101-21,019-0000

OPERATOR: License # 5181

NE SW NE Sec 2 Twp 16 S, Rge 30W
(location) East West

Name DONALD C. SLAWSON

Address 200 Douglas Bldg.

City/State/Zip Wichita, Kansas 67202

Contact Person Bill Horigan

Phone (316)263-3201 Ext. 134

3610 Ft North from Southeast Corner of Section

1680 Ft West from Southeast Corner of Section

(Note: Locate well on Section Plat on reverse side)

CONTRACTOR: License # 5657

Nearest lease or unit boundary line 1670 feet.

County Lane

Lease Name York 'II' Well# 3

Name Slawson Drilling Co., Inc.

City/State Wichita, Kansas 67202

Well Drilled For:	Well Class:	Type Equipment:
<input checked="" type="checkbox"/> Oil <input type="checkbox"/> Swd <input checked="" type="checkbox"/> Infield <input checked="" type="checkbox"/> Mud Rotary	<input type="checkbox"/> Gas <input type="checkbox"/> Inj <input type="checkbox"/> Pool Ext. <input type="checkbox"/> Air Rotary	<input type="checkbox"/> Cable
<input type="checkbox"/> OWWO <input type="checkbox"/> Expl <input type="checkbox"/> Wildcat		

Domestic well within 330 feet: yes no

Municipal well within one mile: yes no

If OWWO: old well info as follows:

Depth to Bottom of fresh water 90 feet

Lowest usable water formation Dakota

Depth to Bottom of usable water 1100 feet

Surface pipe by Alternate: 1 2

Surface pipe to be set 360 feet

Conductor pipe if any required feet

Ground surface elevation 2677 feet MSL

This Authorization Expires 7/27/85

Approved By 7/27/84 *R*

Operator

Well Name

Comp Date Old Total Depth

Projected Total Depth 4400 feet

Projected Formation at TD MISS

Expected Producing Formations LKC, MARM, CHER

I certify that we will comply with K.S.A. 55-101, et seq., plus eventually plugging hole to K.C.C. specifications.

Date 7/27/84 Signature of Operator or Agent

J. Theodore Sandberg
J. Theodore Sandberg

Division Mgr./Geologist

Form C-1 4/84

MHC/NOHE 7/27/84


Must be filed with the K.C.C. five (5) days prior to commencing well
 This card void if drilling not started within six (6) months of date received by K.C.C.

Important procedures to follow:

RECEIVED
 STATE CORPORATION COMMISSION

7-27-84
 CONSERVATION DIVISION
 Wichita, Kansas

A Regular Section of Land
1 Mile = 5,280 Ft.

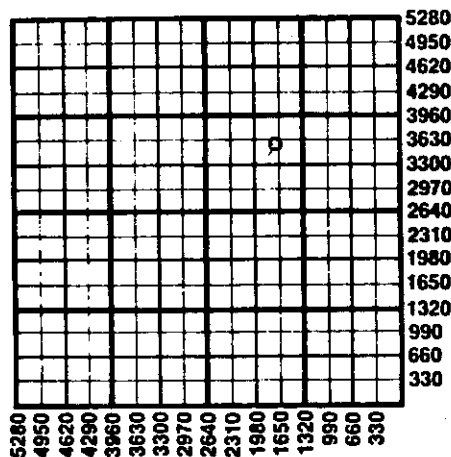

1. Notify District office before setting surface casing.
2. Set surface casing by circulating cement to the top.
3. File completion forms ACO-1 with K.C.C. within 90 days of well completion, following instructions on ACO-1, side 1, and including copies of wireline logs.
4. Notify District office 48 hours prior to old well workover or re-entry.
5. Prior to plugging, prepare a plugging plan, then obtain agreement from the appropriate district office for an approved plugging plan.
6. Submit plugging report (CP-4) to K.C.C. after plugging is completed.
7. Obtain an approved injection docket number before disposing of salt water.
8. Notify K.C.C. within 10 days when injection commences or terminates.
- *9. If an alternate 2 completion, cement in the production pipe from below any usable water to surface within 120 days of spud date.

*Circulate alternative cementing material per 82-3-106 (b)4.

State Corporation Commission of Kansas
 Conservation Division
 200 Colorado Derby Building
 Wichita, Kansas 67202
 (316) 263-3238