

NOTICE OF INTENTION TO DRILL

(see rules on reverse side)

Starting Date 11 15 85
month day year

API Number 15- 165-21,334-0000

OPERATOR: License # ... 4525 App.
Name ... A. Francis Vonfeldt Co.
Address .. Box 357, 505 S. Colo.
City/State/Zip .. Plainville, KS 67663
Contact Person ... A. Francis Vonfeldt
Phone ... (913) 434-2408

NE. NW. NE. Sec. 7. Twp. 16. S, Rg. 16. ... X West
..... 4950 Ft. from South Line of Section
..... 1650 Ft. from East Line of Section

(Note: Locate well on Section Plat on reverse side)

CONTRACTOR: License # 4083
Name Western Kansas Drilling, Inc.
City/State 1111 S. 30th, Box 126, Hays, KS 67301

Nearest lease or unit boundary line 330 feet
County ... Rush Co.
Lease Name ... Dome Well # ... 1
Ground surface elevation feet MSL
Domestic well within 330 feet: _____ yes no
Municipal well within one mile: _____ yes no
Surface pipe by Alternate: 1 2 _____
Depth to bottom of fresh water ... 100
Depth to bottom of usable water ... 660
Surface pipe planned to be set ... 1000
Projected Total Depth 3550 feet
Formation ... Arbuckle-K.C.

Well Drilled For: Well Class: Type Equipment:
 Oil _____ SWD Infield Mud Rotary
_____ Gas _____ Inj _____ Pool Ext. _____ Air Rotary
_____ OWWO _____ Expl _____ Wildcat _____ Cable

If OWWO: old well info as follows:

Operator
Well Name
Comp Date Old Total Depth

I certify that well will comply with K.S.A. 55-101, et seq., plus eventually plugging hole to KCC specifications.

_____ cementing will be done immediately upon setting production casing.

Date .. 11/8/85 Signature of Operator or Agent *Calvin Duckham* Title ... as agent

For KCC Use:

Conductor Pipe Required feet; Minimum Surface Pipe Required feet per Alt. 1 2

This Authorization Expires 5-8-86 Approved By 11-8-85 *Ra*

Must be filed with the K.C.C. five (5) days prior to commencing well
This card void if drilling not started within six (6) months of date received by K.C.C.

Important procedures to follow:

RECEIVED
STATE CORPORATION COMMISSION


Notify District office before setting surface casing.

A Regular Section of Land
1 Mile = 5,280 Ft.

NOV 2 1985

CONSERVATION DIVISION
Wichita, Kansas

2. Set surface casing by circulating cement to the top.
3. File completion forms ACO-1 with K.C.C. within 90 days of well completion, following instructions on ACO-1, side 1, and including copies of wireline logs.
4. Notify District office 48 hours prior to old well workover or re-entry.
5. Prior to filing Intent, prepare a proposed plugging plan in case well is D & A, then obtain approval of plan when calling district office prior to setting surface pipe.
6. Submit plugging report (CP-4) to K.C.C. after plugging is completed.
7. Obtain an approved injection docket number before disposing of salt water.
8. Notify K.C.C. within 10 days when injection commences or terminates.
9. If an alternate 2 completion, cement in the production pipe from below any usable water to surface within 120 days of spud date.

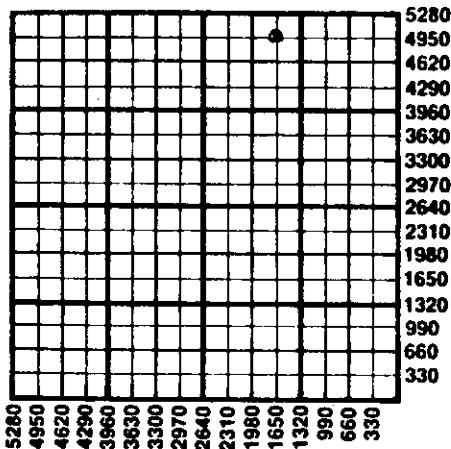

State Corporation Commission of Kansas
Conservation Division
200 Colorado Derby Building
Wichita, Kansas 67202
(316) 263-3238