

NOTICE OF INTENTION TO DRILL

(see rules on reverse side)

CORRECTION

12-3-85

Starting Date ..... 11 - 15 - 85  
month day year

API Number 15— 101-21,249 - 0000

N/2 N/2 NW ..... Sec. 12 Twp. 16 S, Rg. 30 X East  
4950 ..... Ft. from South Line of Section  
3950 ..... Ft. from East Line of Section

(Note: Locate well on Section Plat on reverse side)

*X* OPERATOR: License # 5363  
Name BEREEXO INC.  
Address 970 Fourth Financial Center  
City/State/Zip Wichita, KS 67202  
Contact Person Max S. Houston  
Phone (316)265-3311

Nearest lease or unit boundary line ..... 330 ..... feet  
County Lane

CONTRACTOR: License # 6033  
Name Murfin Drilling  
City/State Wichita, KS

Lease Name York Estate Well # 1  
Ground surface elevation 2674 ..... feet MSL

Well Drilled For: Well Class: Type Equipment:  
X Oil SWD Infield X Mud Rotary  
Gas Inj X Pool Ext. Air Rotary  
OWWO Expl Wildcat Cable

Domestic well within 330 feet: yes X no  
Municipal well within one mile: yes X no  
Surface pipe by Alternate: 1 2 X

If OWWO: old well info as follows:

Depth to bottom of fresh water 100  
Depth to bottom of usable water 1250  
Surface pipe planned to be set 8-5/8" @ 300'  
Projected Total Depth 4425 ..... feet  
Formation Mississippian

Operator .....  
Well Name .....  
Comp Date ..... Old Total Depth .....

I certify that well will comply with K.S.A. 55-101, et seq., plus eventually plugging hole to KCC specifications.

*was. Baker Corp.*

\_\_\_\_\_ cementing will be done immediately upon setting production casing.

Date 11-11-85 Signature of Operator or Agent *Janet L. Bard* Title Geological Secretary

For KCC Use:

Conductor Pipe Required ..... feet; Minimum Surface Pipe Required ..... feet per Alt. 1 2


This Authorization Expires 5-12-86 Approved By 11-12-85

Must be filed with the K.C.C. five (5) days prior to commencing well  
This card void if drilling not started within six (6) months of date received by K.C.C.

### Important procedures to follow:

1. Notify District office before setting surface casing.
2. Set surface casing by circulating cement to the top.
3. File completion forms ACO-1 with K.C.C. within 90 days of well completion, following instructions on ACO-1, side 1, and including copies of wireline logs.
4. Notify District office 48 hours prior to old well workover or re-entry.
5. Prior to filing Intent, prepare a proposed plugging plan in case well is D & A, then obtain approval of plan when calling district office prior to setting surface pipe.
6. Submit plugging report (CP-4) to K.C.C. after plugging is completed.
7. Obtain an approved injection docket number before disposing of salt water.
8. Notify K.C.C. within 10 days when injection commences or terminates.
9. If an alternate 2 completion, cement in the production pipe from below any usable water to surface within 120 days of spud date.

### A Regular Section of Land 1 Mile = 5,280 Ft.

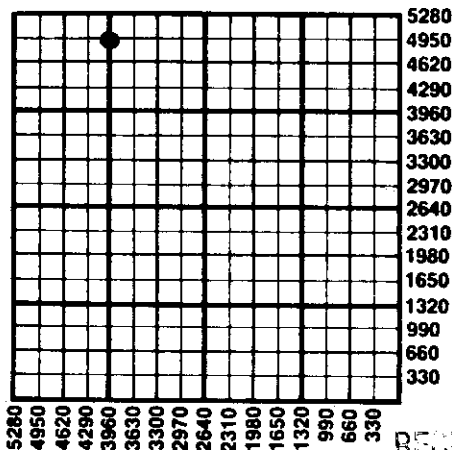

RECEIVED  
STATE CORPORATION COMMISSION

DEC 2 1985  
12-2-85  
CONSERVATION DIVISION  
Wichita, Kansas

State Corporation Commission of Kansas  
Conservation Division  
200 Colorado Derby Building  
Wichita, Kansas 67202  
(316) 263-3238