

CARD MUST BE TYPED

State of Kansas
NOTICE OF INTENTION TO DRILL

CARD MUST BE SIGNED

(see rules on reverse side)

Starting Date: 3 4 1985
month day year 4:00

API Number IS- 165-21,291-0000

OPERATOR: License # 6148

SE SE SW Sec .. 1 .. Twp .. 16 .. S, Rge 18 ..
(location) East West

Name WALTERS & WALTERS

Address 5924 Royal Lane #155

City/State/Zip Dallas, Texas 75230

Contact Person Mike Walters

Phone (214) 363-5997

..... 475 Ft North from Southeast Corner of Section

..... 3115 Ft West from Southeast Corner of Section

(Note: Locate well on Section Plat on reverse side)

CONTRACTOR: License # 9087

Name R & C Drilling, Inc.

City/State Hays, Kansas 67601

Nearest lease or unit boundary line 475 feet.

County RUSH

Lease Name LEGLEITER Well# 1

Domestic well within 330 feet : yes no

Municipal well within one mile : yes no

Well Drilled For: Well Class: Type Equipment:

Oil Swd Infield Mud Rotary

Gas Inj Pool Ext. Air Rotary

OWWO Expl Wildcat Cable

Depth to Bottom of fresh water 385 feet

Lowest usable water formation Dakota

Depth to Bottom of usable water 405 feet

Surface pipe by Alternate : 1 2

Surface pipe to be set 40.5 feet

Conductor pipe if any required feet

Ground surface elevation feet MSI.

This Authorization Expires 9-1-85

Approved By 3-1-85 [Signature]

If OWWO: old well info as follows:

Operator

Well Name

Comp Date Old Total Depth

Projected Total Depth 3700 feet

Projected Formation at TD Arbuckle

Expected Producing Formations

I certify that we will comply with K.S.A. 55-101, et seq., plus eventually plugging hole to K.C.C. specifications.

Date 3-1-85 Signature of Operator or Agent [Signature]

Title Agent [Signature]


WMC/MONE 3-1-85

Must be filed with the K.C.C. five (5) days prior to commencing well
This card void if drilling not started within six (6) months of date received by K.C.C.

RECEIVED
STATE CORPORATION COMMISSION

MAR 1 1985

A Regular Section of Land
1 Mile = 5,280 Ft.

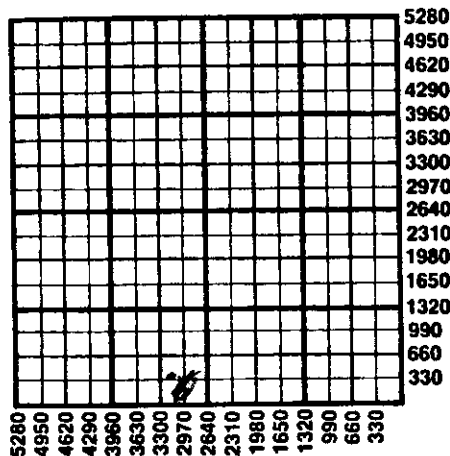

Important procedures to follow :

CONSERVATION DIVISION
Wichita, Kansas

1. Notify District office before setting surface casing.
2. Set surface casing by circulating cement to the top.
3. File completion forms ACO-1 with K.C.C. within 90 days of well completion, following instructions on ACO-1, side 1, and including copies of wireline logs.
4. Notify District office 48 hours prior to old well workover or re-entry.
5. Prior to plugging, prepare a plugging plan, then obtain agreement from the appropriate district office for an approved plugging plan.
6. Submit plugging report (CP-4) to K.C.C. after plugging is completed.
7. Obtain an approved injection docket number before disposing of salt water.
8. Notify K.C.C. within 10 days when injection commences or terminates.
9. If an alternate 2 completion, cement in the production pipe from below any usable water to surface within 120 days of spud date.

State Corporation Commission of Kansas
Conservation Division
200 Colorado Derby Building
Wichita, Kansas 67202
(316) 263-3238