

CARD MUST BE TYPED

State of Kansas  
**NOTICE OF INTENTION TO DRILL**  
(see rules on reverse side)

CARD MUST BE SIGNED

Starting Date: ..... 2 ..... 7 ..... 85 .....  
month day year

API Number 15- 101-21,125-00-00

OPERATOR: License # 5123

SW NW SE Sec 23.. Twp . 16. S, Rge . 30.  East  
(location)  West

Name Pickrell Drilling Company

Address 110 N. Market, Suite 205

City/State/Zip Wichita, Kansas 67202

Contact Person Jay McNeil

Phone (316) 262-8427

1650 ..... Ft North from Southeast Corner of Section

2310 ..... Ft West from Southeast Corner of Section

(Note: Locate well on Section Plat on reverse side)

CONTRACTOR: License # 5123

Nearest lease or unit boundary line ..... 330 ..... feet.

Name Pickrell Drilling Company

County Lane

City/State Wichita, Kansas

Lease Name Roemer Well# 1-C

Well Drilled For: Well Class: Type Equipment:

- Oil  Swd  Infield  Mud Rotary
- Gas  Inj  Pool Ext.  Air Rotary
- OWWO  Expl  Wildcat  Cable

Domestic well within 330 feet :  yes  no

Municipal well within one mile :  yes  no

If OWWO: old well info as follows:

Depth to Bottom of fresh water ..... 145 ..... feet

Lowest usable water formation ..... Dakota

Depth to Bottom of usable water ..... 1125-960 ..... feet

Surface pipe by Alternate : 1  2

Surface pipe to be set ..... 300+ ..... feet

Conductor pipe if any required ..... feet

Ground surface elevation ..... feet MSL

This Authorization Expires ..... 7-31-85

Approved By ..... 1-31-85

I certify that we will comply with K.S.A. 55-101, et seq., plus eventually plugging hole to K.C.C. specifications.

Date 1-31-85 Signature of Operator or Agent


Title Chief Geologist

MHC/KOHE 1-31-85

Must be filed with the K.C.C. five (5) days prior to commencing well  
This card void if drilling not started within six (6) months of date received by K.C.C.

5861 I 3 N V I  
1-31-85

STATE CORPORATION COMMISSION  
1865-1

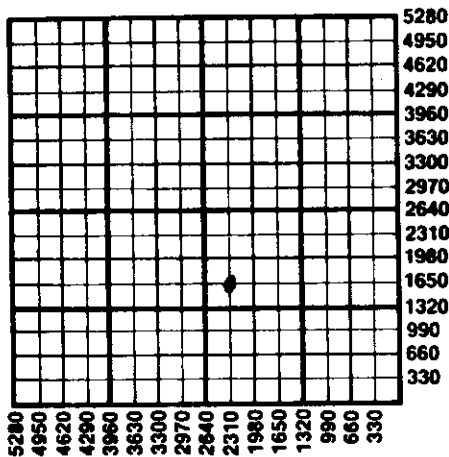

**Important procedures to follow :**

1. Notify District office before setting surface casing.
2. Set surface casing by circulating cement to the top.
3. File completion forms ACO-1 with K.C.C. within 90 days of well completion, following instructions on ACO-1, side 1, and including copies of wireline logs.
4. Notify District office 48 hours prior to old well workover or re-entry.
5. Prior to plugging, prepare a plugging plan, then obtain agreement from the appropriate district office for an approved plugging plan.
6. Submit plugging report (CP-4) to K.C.C. after plugging is completed.
7. Obtain an approved injection docket number before disposing of salt water.
8. Notify K.C.C. within 10 days when injection commences or terminates.
9. If an alternate 2 completion, cement in the production pipe from below any usable water to surface within 120 days of spud date.

**State Corporation Commission of Kansas  
Conservation Division  
200 Colorado Derby Building  
Wichita, Kansas 67202  
(316) 263-3238**