

CARD MUST BE TYPED

State of Kansas
NOTICE OF INTENTION TO DRILL
(see rules on reverse side)

CARD MUST BE SIGNED

Starting Date: 12-14-84
month day year

API Number 15- 101-21,097-0000

OPERATOR: License # 5405

SE. NE. NW. Sec .25. Twp .16 S, Rge 30. East
(location) West

Name Oil Capital Corporation

Address 520 Farmers & Bankers Bldg.

City/State/Zip Wichita, KS 67202

Contact Person Jack L. Partridge

Phone 316-262-1841

..... 4290..... Ft North from Southeast Corner of Section

..... 2970..... Ft West from Southeast Corner of Section

(Note: Locate well on Section Plat on reverse side)

CONTRACTOR: License # 5422

Nearest lease or unit boundary line 990 feet.

County ... Lane

Name Abercrombie Drilling, Inc.

Lease Name Dickey Well# 5

City/State Wichita, KS

Domestic well within 330 feet : yes no

Well Drilled For: Well Class: Type Equipment:

Oil Swd Infield Mud Rotary

Gas Inj Pool Ext. Air Rotary

OWWO Expl Wildcat Cable

Municipal well within one mile : yes no

If OWWO: old well info as follows:

Depth to Bottom of fresh water 125 feet

Lowest usable water formation Dakota

Depth to Bottom of usable water 1125 feet

Surface pipe by Alternate : 1 2

Surface pipe to be set 350' feet

Conductor pipe if any required None

Ground surface elevation feet MSL.

Operator

Well Name

Comp Date Old Total Depth

Projected Total Depth 4600 feet

Projected Formation at TD Mississippian

Expected Producing Formations Mississippian

This Authorization Expires 5-30-85

Approved By 11-30-84 [Signature]

I certify that we will comply with K.S.A. 55-101, et seq., plus eventually plugging hole to K.C.C. specifications.

Date 11-30-84 Signature of Operator or Agent

[Signature]
Jack L. Partridge


Title V.P. Abercrombie Drilling

MHC/KOHE 11/30/84

Must be filed with the K.C.C. five (5) days prior to commencing well
 This card void if drilling not started within six (6) months of date received by K.C.C.

WICHITA, KANSAS
 CONSERVATION DIVISION
 11-30-84
 NOV 30 1984

RECEIVED
 STATE CORPORATION COMMISSION
 A Regular Section of Land

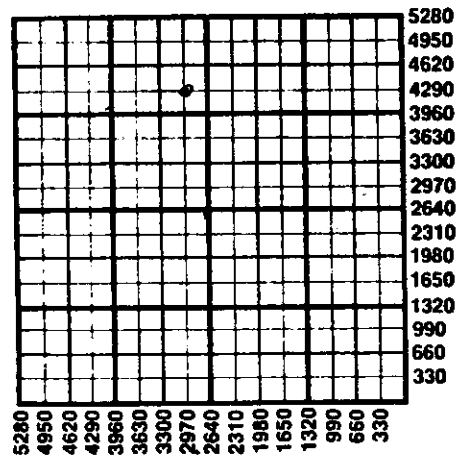

Important procedures to follow:

1. Notify District office before setting surface casing.
2. Set surface casing by circulating cement to the top.
3. File completion forms ACO-1 with K.C.C. within 90 days of well completion, following instructions on ACO-1, side 1, and including copies of wireline logs.
4. Notify District office 48 hours prior to old well workover or re-entry.
5. Prior to plugging, prepare a plugging plan, then obtain agreement from the appropriate district office for an approved plugging plan.
6. Submit plugging report (CP-4) to K.C.C. after plugging is completed.
7. Obtain an approved injection docket number before disposing of salt water.
8. Notify K.C.C. within 10 days when injection commences or terminates.
9. If an alternate 2 completion, cement in the production pipe from below any usable water to surface within 120 days of spud date.

State Corporation Commission of Kansas
 Conservation Division
 200 Colorado Derby Building
 Wichita, Kansas 67202
 (316) 263-3238