

CARD MUST BE TYPED

State of Kansas

CARD MUST BE SIGNED

NOTICE OF INTENTION TO DRILL

Collection
2-12-86

CORRECTION

(see rules on reverse side)

Starting Date 2 10 86
month day year

API Number 15— 165-21, 353-0006

OPERATOR: License # 5313
Name F & M OIL CO., INC.
Address 422 Union Center
City/State/Zip Wichita, Kansas 67202
Contact Person R. D. Messinger
Phone (316)262-2636

..... East
SW NE NE. Sec....19 Twp.16.. S, Rg...18W. West
..... 4290..... Ft. from South Line of Section
..... 990..... Ft. from East Line of Section

(Note: Locate well on Section Plat on reverse side)

CONTRACTOR: License # 5103
Name Union Drilling Co., Inc.
City/State Wichita, Kansas 67202

Nearest lease or unit boundary line 990..... feet
County...Rush.....

Well Drilled For: Well Class: Type Equipment:
 Oil SWD Infield Mud Rotary
 Gas Inj Pool Ext. Air Rotary
 OWWO Expl Wildcat Cable

Lease Name...Haas "A"..... Well #.....1.....
Ground surface elevation 2019'..... feet MSL
Domestic well within 330 feet: yes no
Municipal well within one mile: yes no
Surface pipe by Alternate: 1 2 *X*

If OWWO: old well info as follows:

Operator
Well Name
Comp Date Old Total Depth.....

Depth to bottom of fresh water.....100.....
Depth to bottom of usable water600.....
* Surface pipe planned to be set **330**.....
Projected Total Depth 3650..... feet
Formation..... Regan.....

I certify that well will comply with K.S.A. 55-101, et seq., plus eventually plugging hole to KCC specifications.

..... cementing will be done immediately upon setting production casing.

Date 2-10-86 Signature of Operator or Agent

R. D. Messinger Vice-President *1200's up*

For KCC Use:

Conductor Pipe Required feet; Minimum Surface Pipe Required 330 feet per Alt.


This Authorization Expires 2-6-86 Approved By 2-6-86

Must be filed with the K.C.C. five (5) days prior to commencing well
This card void if drilling not started within six (6) months of date received by K.C.C.

Important procedures to follow:

1. Notify District office before setting surface casing.
2. Set surface casing by circulating cement to the top.
3. File completion forms ACO-1 with K.C.C. within 90 days of well completion, following instructions on ACO-1, side 1, and including copies of wireline logs.
4. Notify District office 48 hours prior to old well workover or re-entry.
5. Prior to filing Intent, prepare a proposed plugging plan in case well is D & A, then obtain approval of plan when calling district office prior to setting surface pipe.
6. Submit plugging report (CP-4) to K.C.C. after plugging is completed.
7. Obtain an approved injection docket number before disposing of salt water.
8. Notify K.C.C. within 10 days when injection commences or terminates.
9. If an alternate 2 completion, cement in the production pipe from below any usable water to surface within 120 days of spud date.

A Regular Section of Land 1 Mile = 5,280 Ft.

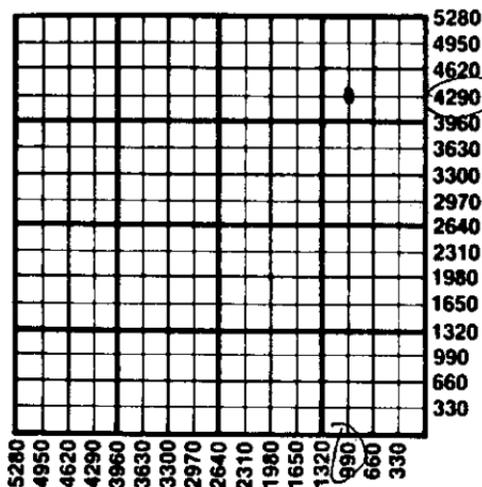

RECEIVED
STATE CORPORATION COMMISSION

FEB 12 1936

CONSERVATION DIVISION

State Corporation Commission of Kansas
Conservation Division
200 Colorado Derby Building
Wichita, Kansas 67202
(316) 263-3238