

CARD MUST BE TYPED

State of Kansas

CARD MUST BE SIGNED

NOTICE OF INTENTION TO DRILL

(see rules on reverse side)

Expected Spud Date. September 1, 1987
month day yearAPI Number 15—101-21407-0000

OPERATOR: License # 4656
 Name Davis Petroleum, Inc.
 Address Route 1, Box 183-B
 City/State/Zip Great Bend, KS 67530
 Contact Person L. D. Davis
 Phone 316-793-3051

SE NW Sec. 34 Twp. 16 S, Rg. 30 X East
3300' Ft. from South Line of Section
3300' Ft. from East Line of Section

(Note: Locate well on Section Plat on reverse side)

CONTRACTOR: License # 5864
 Name LOBO Drilling Company
 City/State Great Bend, KS 67530

Nearest lease or unit boundary line 660' feet
 County Lane
 Lease Name Wilson Well # 1
 Ground surface elevation 2860 (estimate) feet MSL
 Domestic well within 330 feet: yes X no
 Municipal well within one mile: yes X no
 Depth to bottom of fresh water 250'
 Depth to bottom of usable water 1300'
 Surface pipe by Alternate: 1 2 X
 Surface pipe planned to be set 320'
 Conductor pipe required None
 Projected Total Depth 4500' feet
 Formation Miss.

Well Drilled For: Well Class: Type Equipment:
X Oil Storage Infield X Mud Rotary
Gas Inj Pool Ext. Air Rotary
OWWO Expl X Wildcat Cable

If OWWO: old well info as follows:

Operator
 Well Name
 Comp Date Old Total Depth

I certify that well will comply with K.S.A. 55-101, et seq., plus eventually plugging hole to KCC specifications.

Date 8-6-87 Signature of Operator or AgentJ. M. Vess

Title

For KCC Use:


Conductor Pipe Required feet; Minimum Surface Pipe Required 250 feet per Alt. 1 0
 This Authorization Expires 8-7-88 Approved By DA 8-7-87

Must be filed with the K.C.C. five (5) days prior to commencing well
This card void if drilling not started within six (6) months of date received by K.C.C.

Important procedures to follow:

1. Notify District office before setting surface casing.
2. Set surface casing by circulating cement to the top.
3. File completion forms ACO-1 with K.C.C. within 120 days of well spud date, following instructions on ACO-1, side 1, and including copies of wireline logs.
4. Notify District office 48 hours prior to old well workover or re-entry.
5. Prior to filing Intent, prepare a proposed plugging plan in case well is D & A, then obtain approval of plan when calling district office prior to setting surface pipe.
6. Submit plugging report (CP-4) to K.C.C. after plugging is completed.
7. Obtain an approved injection docket number before disposing of salt water.
8. Notify K.C.C. within 10 days when injection commences or terminates.
9. If an alternate 2 completion, cement in the production pipe from below any usable water to surface within 120 days of spud date.

**A Regular Section of Land
1 Mile = 5,280 Ft.**

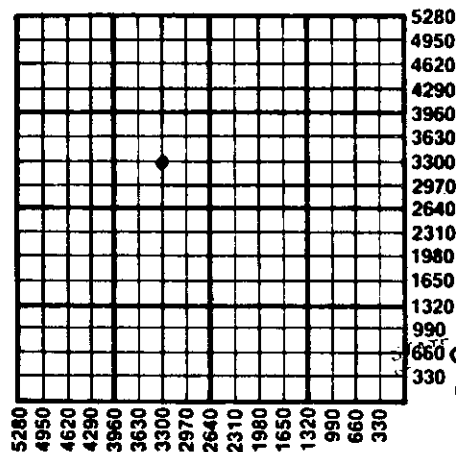

RECEIVED
8-7-87
AUG - 7 1987

CONSERVATION DIVISION
Wichita, Kansas

State Corporation Commission of Kansas
Conservation Division
200 Colorado Derby Building
Wichita, Kansas 67202-1212
(316) 263-3238