

CARD MUST BE TYPED

State of Kansas
NOTICE OF INTENTION TO DRILL
(see rules on reverse side)

CARD MUST BE SIGNED

Starting Date: 12 06 84
month day year 1.50

API Number 15- 101-21,103-0000

OPERATOR: License # 5151

200' E of E/2 SE Sec 34 Twp 16. S, Rge 30. East West
(location)

Name Gear Petroleum Co., Inc.

Address 300 Sutton Place

City/State/Zip Wichita, KS 67202

Contact Person Jim Thatcher

Phone 316-265-3351

..... 1320 Ft North from Southeast Corner of Section

..... 460 Ft West from Southeast Corner of Section

(Note: Locate well on Section Plat on reverse side)

CONTRACTOR: License # 5302

Nearest lease or unit boundary line 460 feet.

County Lane

Lease Name Sharp Well# 2-34

Name Red Tiger Drilling Co.

City/State Wichita, KS 67202

Well Drilled For: Well Class: Type Equipment:

- Oil Swd Infield Mud Rotary
- Gas Inj Pool Ext. Air Rotary
- OWWO Expl Wildcat Cable

Domestic well within 330 feet: yes no

Municipal well within one mile: yes no

If OWWO: old well info as follows:

Operator

Well Name

Comp Date Old Total Depth

Projected Total Depth 4600 feet

Projected Formation at TD Mississippi

Expected Producing Formations LKC/Marmaton

Depth to Bottom of fresh water 200 feet

Lowest usable water formation Dakota

Depth to Bottom of usable water 1100 feet

Surface pipe by Alternate: 1 2

Surface pipe to be set 320 feet

Conductor pipe if any required none feet

Ground surface elevation unknown feet MSI.

This Authorization Expires 6-5-85

Approved By 12-5-84 R.

I certify that we will comply with K.S.A. 55-101, et seq., plus eventually plugging hole to K.C.C. specifications.

10-5-84

Date Signature of Operator or Agent


Jim Thatcher
Title

Production Engineer

2114C/1104E 12/5/84 Form C-1 4/84

RECEIVED Must be filed with the K.C.C. five (5) days prior to commencing well
This card void if drilling not started within six (6) months of date received by K.C.C.
STATE CORPORATION COMMISSION

DEC 5 1984
12-5-84
CONSERVATION DIVISION
A Regular Section of Land
1 Mile = 5,280 Ft.

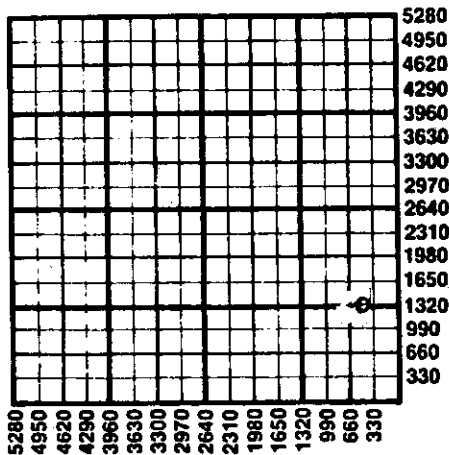

Important procedures to follow :

1. Notify District office before setting surface casing.
2. Set surface casing by circulating cement to the top.
3. File completion forms ACO-1 with K.C.C. within 90 days of well completion, following instructions on ACO-1, side 1, and including copies of wireline logs.
4. Notify District office 48 hours prior to old well workover or re-entry.
5. Prior to plugging, prepare a plugging plan, then obtain agreement from the appropriate district office for an approved plugging plan.
6. Submit plugging report (CP-4) to K.C.C. after plugging is completed.
7. Obtain an approved injection docket number before disposing of salt water.
8. Notify K.C.C. within 10 days when injection commences or terminates.
9. If an alternate 2 completion, cement in the production pipe from below any usable water to surface within 120 days of spud date.

State Corporation Commission of Kansas
Conservation Division
200 Colorado Derby Building
Wichita, Kansas 67202
(316) 263-3238