

NOTICE OF INTENTION TO DRILL

(see rules on reverse side)

Starting Date 4 30 1986 month day year

API Number 15- 101-21,312-0000

OPERATOR: License # 6113
Name Landmark Oil Exploration, Inc.
Address 105 S. Broadway, Suite 1040
City/State/Zip Wichita, Kansas 67202
Contact Person Jeff Wood
Phone 316-265-8181

NE SW SE Sec. 19 Twp. 17 S, Rg. 28 X West
1040 Ft. from South Line of Section
1660 Ft. from East Line of Section

(Note: Locate well on Section Plat on reverse side)

CONTRACTOR: License # 5420
Name White & Ellis Drilling, Inc.
City/State Wichita, Kansas 67202

Nearest lease or unit boundary line 1040 feet
County Lane

Well Drilled For: Well Class: Type Equipment:
X Oil SWD Infield X Mud Rotary
Gas Inj Pool Ext Air Rotary
OWWO X Expl X Wildcat Cable

Lease Name Garton Well # 1-19
Ground surface elevation 2705' feet MSL
Domestic well within 330 feet: yes X no
Municipal well within one mile: yes X no
Surface pipe by Alternate: 1 2 X
Depth to bottom of fresh water 200'
Depth to bottom of usable water 1250' 1350'
Surface pipe planned to be set 250'
Projected Total Depth 4600' feet
Formation Mississippi

If OWWO: old well info as follows:

Operator
Well Name
Comp Date Old Total Depth

I certify that well will comply with K.S.A. 55-101, et seq, plus eventually plugging hole to KCC specifications.

cementing will be done immediately upon setting production casing.

Date 4-25-86 Signature of Operator or Agent Jeffrey R. Wood Title President

For KCC Use:


Conductor Pipe Required feet; Minimum Surface Pipe Required 225 feet per Alt.
This Authorization Expires 10-25-86 Approved By 4-10-86

Must be filed with the K.C.C. five (5) days prior to commencing well  
This card void if drilling not started within six (6) months of date received by K.C.C.

### Important procedures to follow:

1. Notify District office before setting surface casing.
2. Set surface casing by circulating cement to the top.
3. File completion forms ACO-1 with K.C.C. within 90 days of well completion, following instructions on ACO-1, side 1, and including copies of wireline logs.
4. Notify District office 48 hours prior to old well workover or re-entry.
5. Prior to filing Intent, prepare a proposed plugging plan in case well is D & A, then obtain approval of plan when calling district office prior to setting surface pipe.
6. Submit plugging report (CP-4) to K.C.C. after plugging is completed.
7. Obtain an approved injection docket number before disposing of salt water.
8. Notify K.C.C. within 10 days when injection commences or terminates.
9. If an alternate 2 completion, cement in the production pipe from below any usable water to surface within 120 days of spud date.

### A Regular Section of Land 1 Mile = 5,280 Ft.

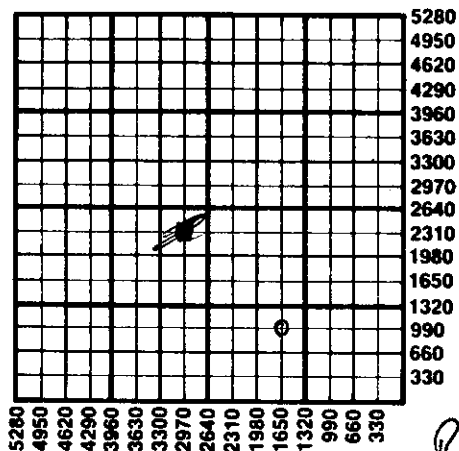

State Corporation Commission of Kansas  
Conservation Division  
200 Colorado Derby Building  
Wichita, Kansas 67202  
(316) 263-3238