

CARD MUST BE TYPED

State of Kansas

CARD MUST BE SIGNED

NOTICE OF INTENTION TO DRILL

(see rules on reverse side)

Expected Spud Date..... 1-18-88.....
month day year

API Number 15— 101-21,456-0000 ✓

OPERATOR: License # 8914
Name H. & C. Oil Operating
Address P.O. Box 86
City/State/Zip Plainville, Ks. 67663
Contact Person Charles R. Ramsay
Phone 913-434-7434

SE SE SE Sec. 36 Twp. 16 S, Rg. 30
330 East
330 West
Ft. from South Line of Section
Ft. from East Line of Section

(Note: Locate well on Section Plat on reverse side)

CONTRACTOR: License #
Name Unknown
City/State

Nearest lease or unit boundary line 330 feet
County Lane

Lease Name Koch Well # A #1
Ground surface elevation est. 2825 feet MSL

Well Drilled For: Well Class: Type Equipment:
 Oil Storage Infield Mud Rotary
 Gas Inj Pool Ext. Air Rotary
 OWWO Expl Wildcat Cable

Domestic well within 330 feet: yes no
Municipal well within one mile: yes no

Depth to bottom of fresh water 175
Depth to bottom of usable water 1350

Surface pipe by Alternate: 1 2
Surface pipe planned to be set 280

If OWWO: old well info as follows:

Conductor pipe required None
Projected Total Depth 4600 feet
Formation Mississippi

Operator
Well Name
Comp Date Old Total Depth

I certify that well will comply with K.S.A. 55-101, et seq., plus eventually plugging hole to KCC specifications.

Date 1-11-88 Signature of Operator or Agent Charles R. Ramsay Title Vice-President

For KCC Use:


Conductor Pipe Required _____ feet; Minimum Surface Pipe Required _____ feet per Alt. X(2)
This Authorization Expires 7-13-88 Approved By RCH 1-13-88

EFFECTIVE DATE: 1-18-88

Must be filed with the K.C.C. five (5) days prior to commencing well
This card void if drilling not started within six (6) months of date received by K.C.C.

Important procedures to follow:

**A Regular Section of Land
1 Mile = 5,280 Ft.**

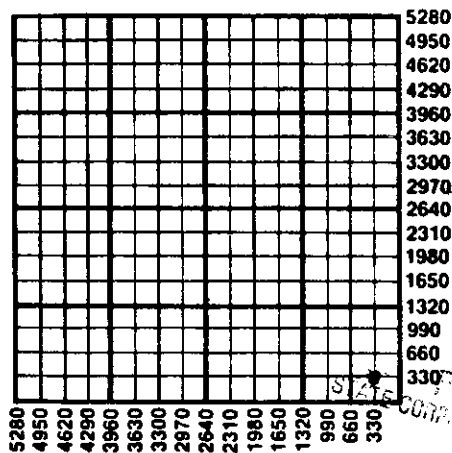

1. Notify District office before setting surface casing.
2. Set surface casing by circulating cement to the top.
3. File completion forms ACO-1 with K.C.C. within 120 days of well spud date, following instructions on ACO-1, side I, and including copies of wireline logs.
4. Notify District office 48 hours prior to old well workover or re-entry.
5. Prior to filing Intent, prepare a proposed plugging plan in case well is D & A, then obtain approval of plan when calling district office prior to setting surface pipe.
6. Submit plugging report (CP-4) to K.C.C. after plugging is completed.
7. Obtain an approved injection docket number before disposing of salt water.
8. Notify K.C.C. within 10 days when injection commences or terminates.
9. If an alternate 2 completion, cement in the production pipe from below any usable water to surface within 120 days of spud date.

RECEIVED
JAN 13 1988
1-13-88
CONSERVATION DIVISION
Wichita, Kansas

State Corporation Commission of Kansas
Conservation Division
200 Colorado Derby Building
Wichita, Kansas 67202-1212
(316) 263-3238